
#1306

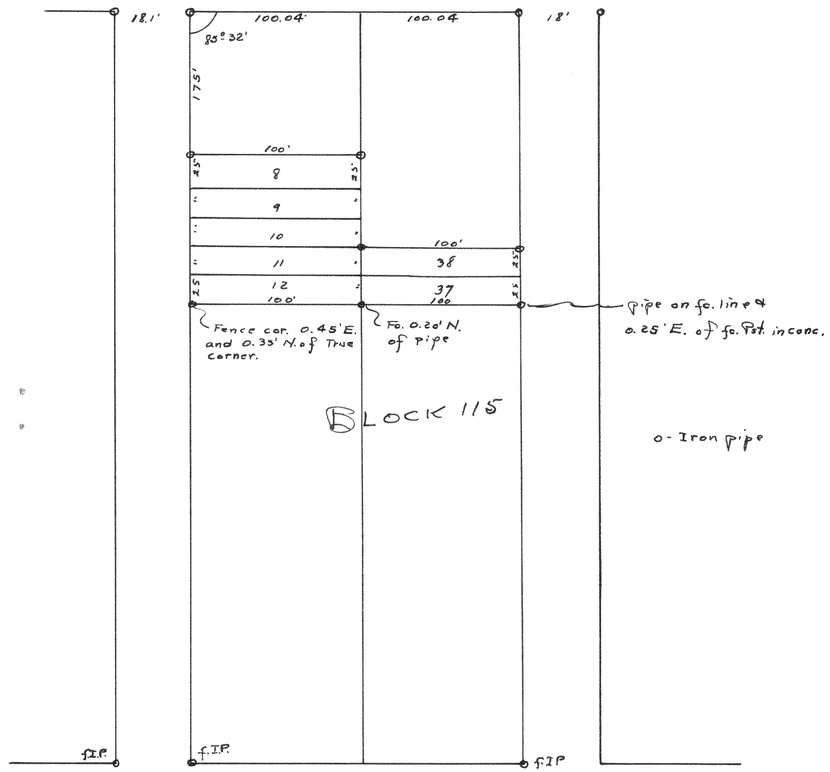


Plat of survey of Lots 8, 9, 10, 11, 12, 37 & 38 of Block 115 of Lake Wauconda Subdivision.

July 6, 1942

Lloyd L. Jensen
County Surveyor

#1307

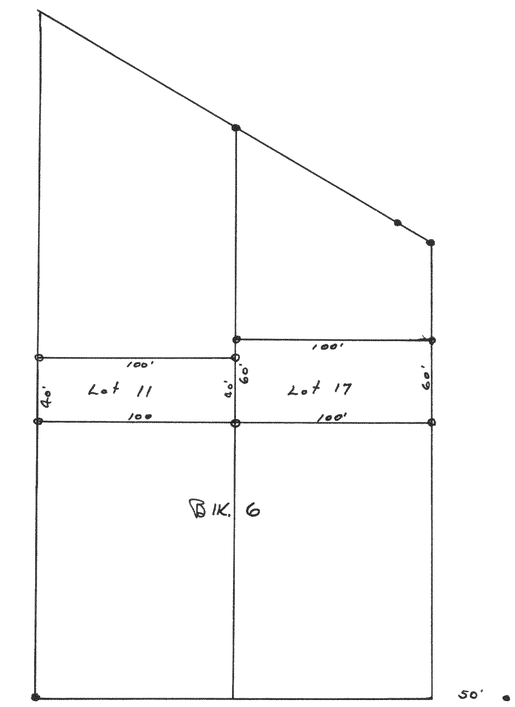

Plat of survey of Lots 11 & 17 of Block 6 of Interlaken Subd. Section I.

June 1942

Lloyd L. Jensen