
#1308

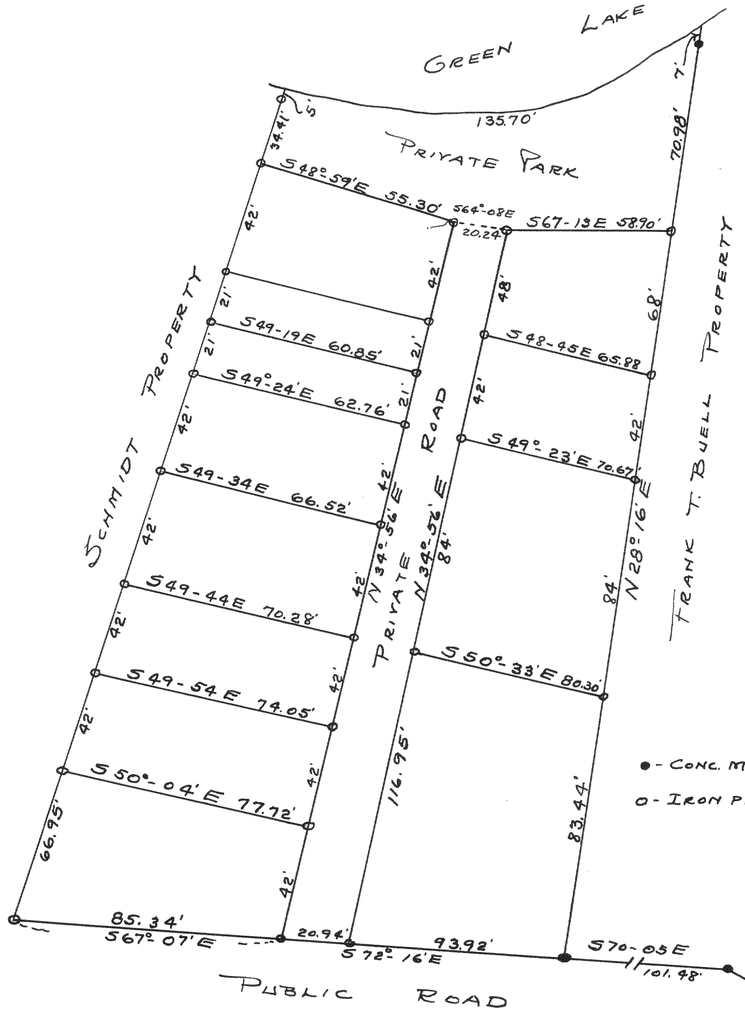


Plat of survey of land formerly owned by Harry W. Loomer which has been divided into lots, located in the Southwest ¼ of the SW¼ of Fractional Section 26, T4N R16E.

Nov. 1942

Lloyd L. Jensen
County Surveyor

South ⅛th. Section Corner of the SW¼ of Section 26, T4N R16E

#1308

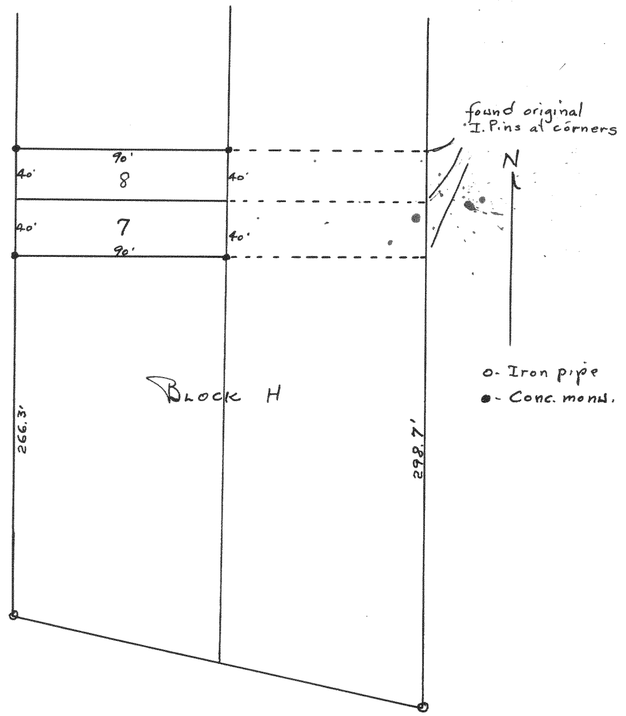

Plat of survey of lots 7 & 8 of Block H of Cisco Beach Subd., located in Section 5, T1N R17E of Walworth County Wisconsin.

Dec. 1942

Lloyd L. Jensen
County Surveyor