
#1314

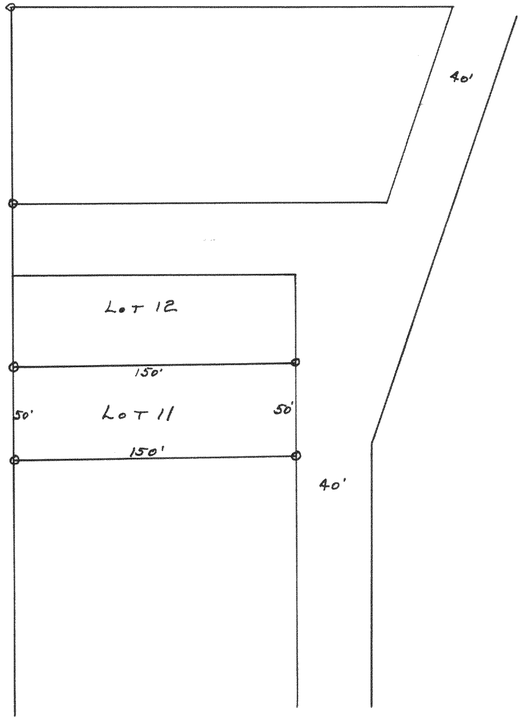


Plat of survey of Lot 11 of Block 8 of Sunset Hills Subdivision.

May 1942

Lloyd S. Jensen
County Surveyor

#1315

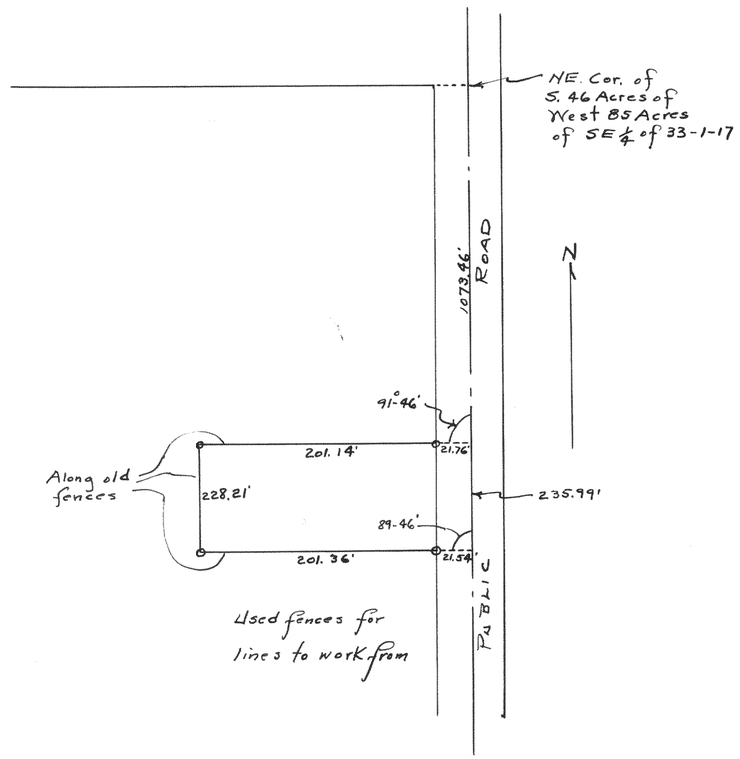

Plat of survey of land in Section 33, TIN R1?E to locate lines of house lot for R.V. Pukl.

Aug. 24, 1942

Lloyd S. Jensen
County Surveyor