
#1321

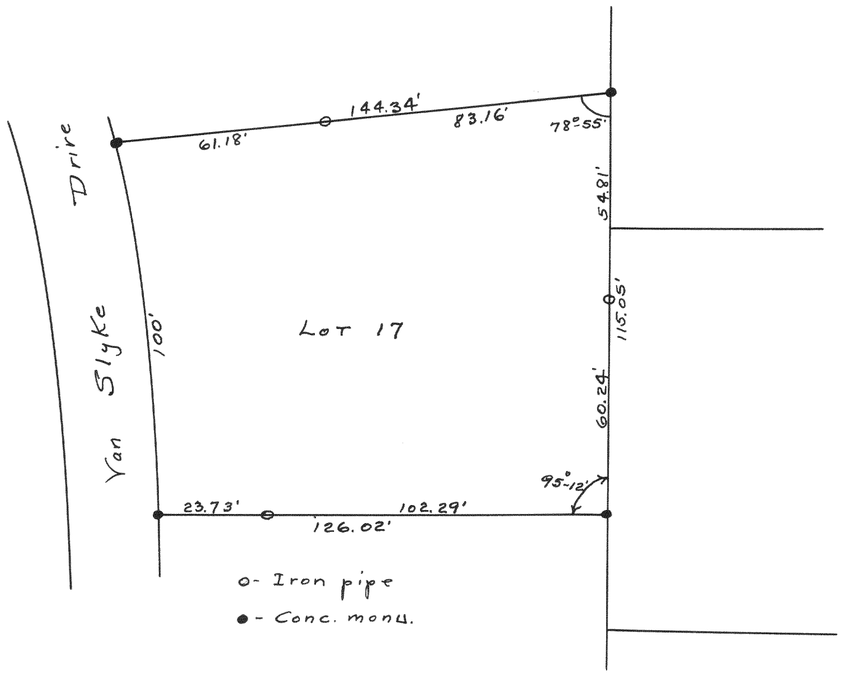


Plat of survey of Lot 17 of Block E of Unit 3 of the County Club Est. Fontana.

June 1942

Lloyd L. Jensen
County Surveyor

#1322

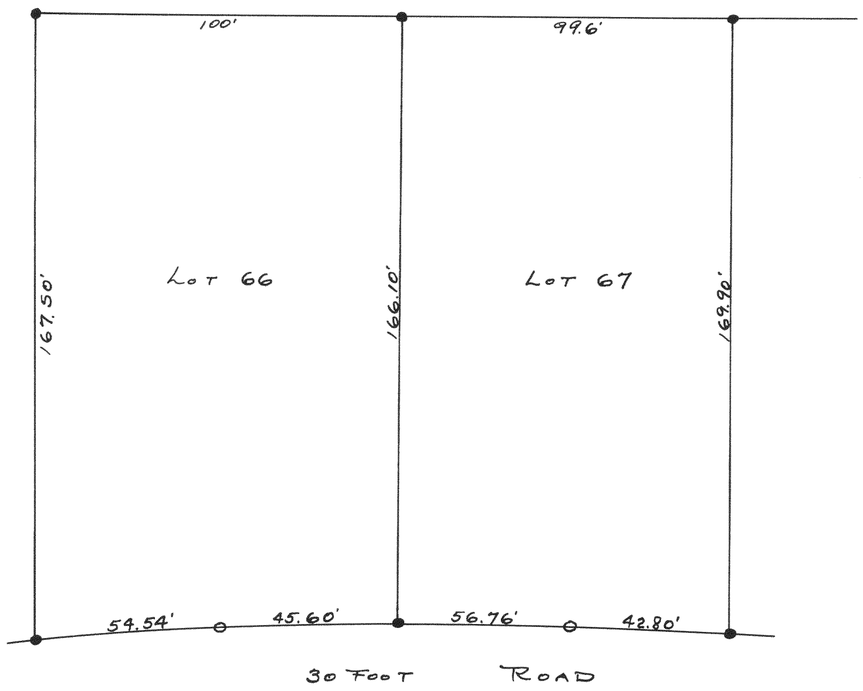

Plat of survey of Lots 66 and 67 of Unit No. 2 of County Club Estates, Fontana.

June 1942

Lloyd L. Jensen
County Surveyor