
#1327

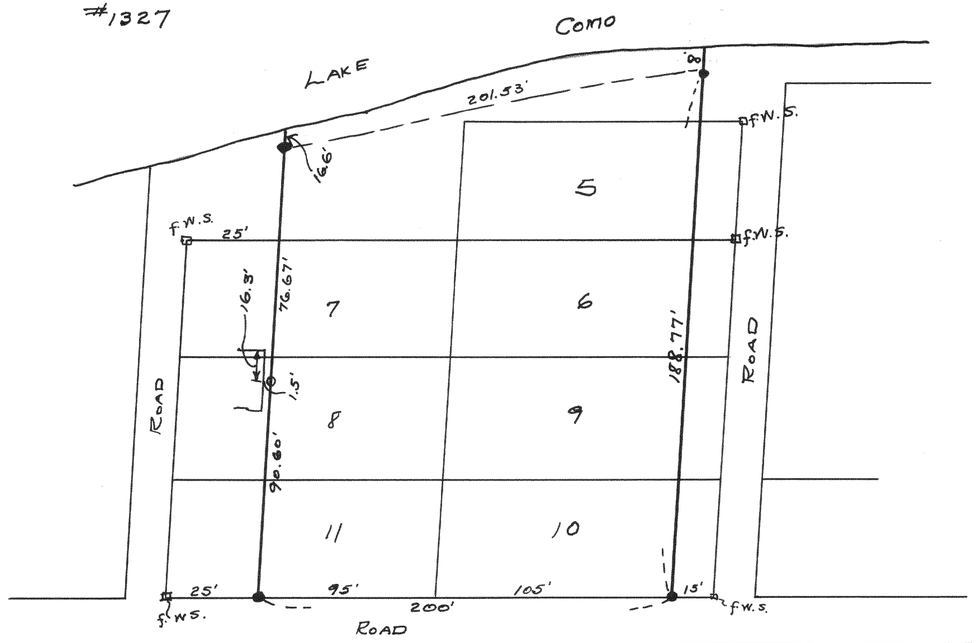

E of C.N.W. R.R.Y


● - Conc. monu.
o - Iron Pipe
□ - wood Stake

Plat of survey of part of lots 5, 6, 7, 8, 9, 10 & 11 of Lackey-Johnson Subd.

July 7, 1942

Lloyd L. Jensen
County Surveyor

#1328

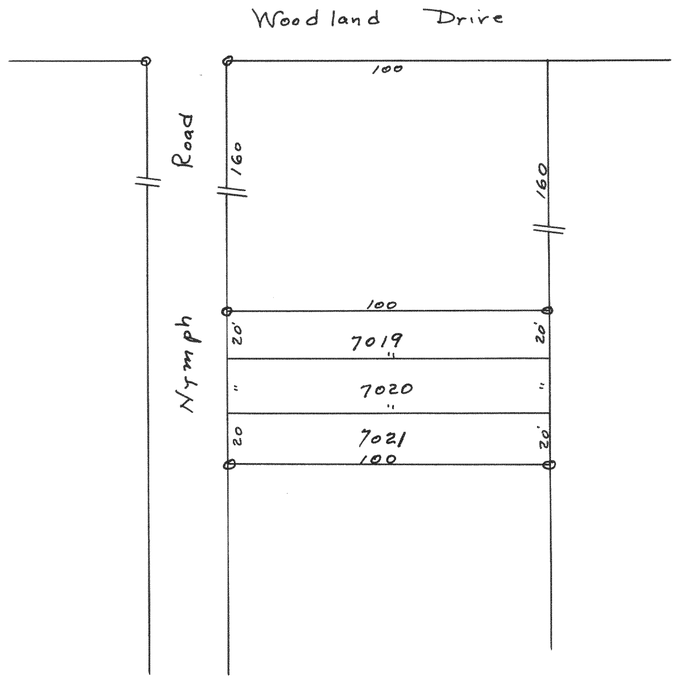

Plat of survey of lots 7019, 7020 & 7021 of Lake Como Beach Subd.

July 16, 1942

Lloyd L. Jensen
County Surveyor