
#1332

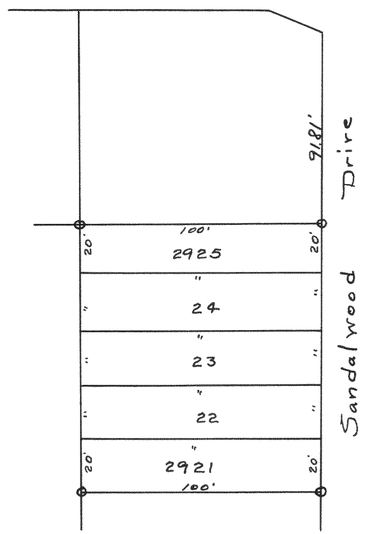


Plat of survey of lots in Peel Lake Subd.

Sept. 5, 1941

Floyd L. Jensen
County Surveyor

#1333

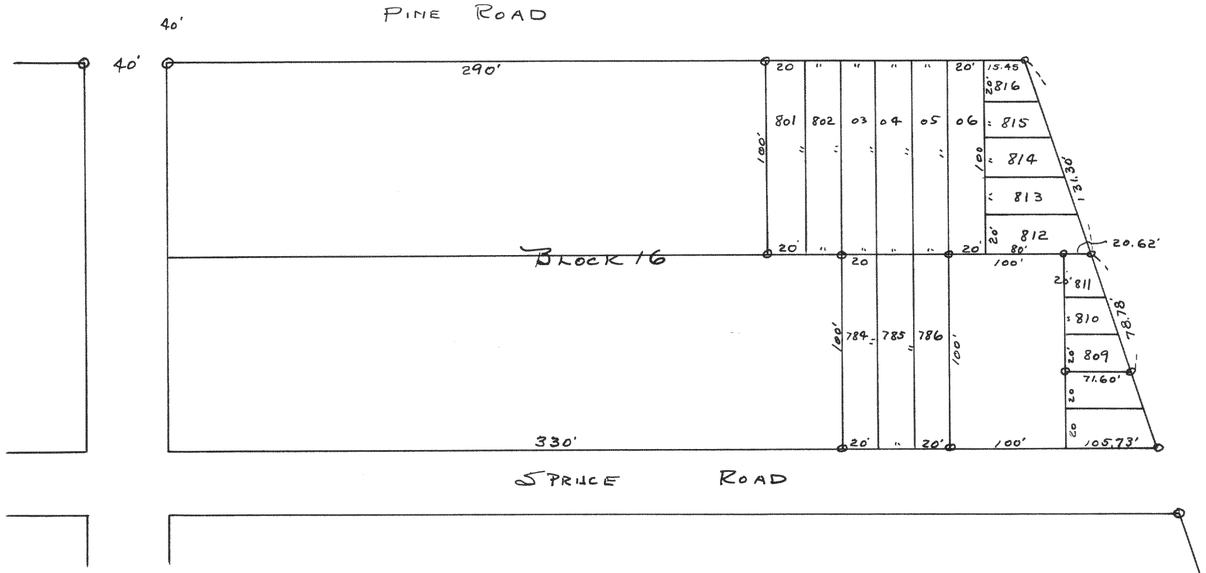

Plat of survey of Lots in Blk. 16 of Section 1 of Peel Lake Subd.

Sept. 7, 1942

Floyd L. Jensen
County Surveyor