
#1337

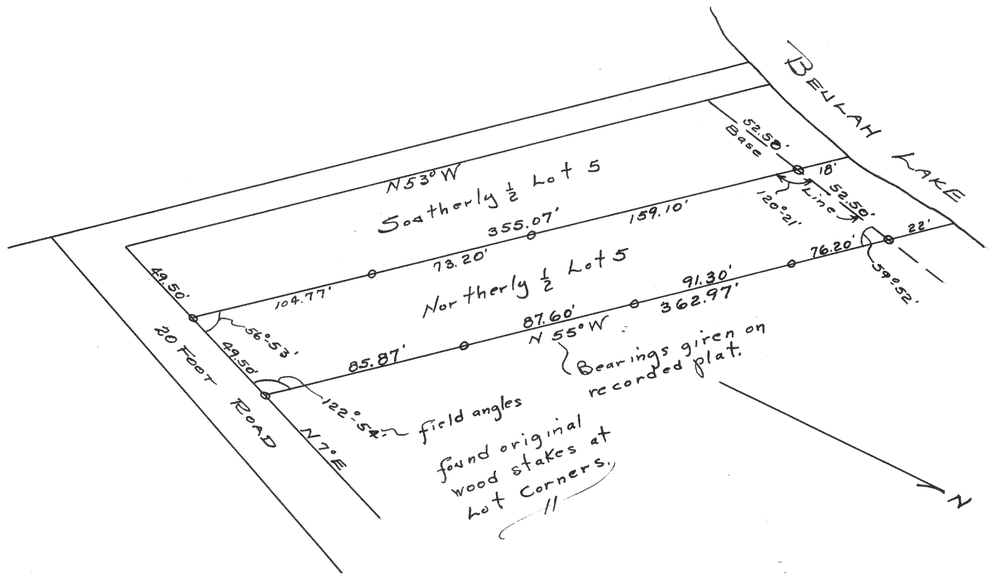


Plat of survey of the Northerly ½ of Lot 5 of Kings Park Subdivision, located in fractional Section 17, T47N R18E.

July 1942

Lloyd L. Jensen
County Surveyor

#1338

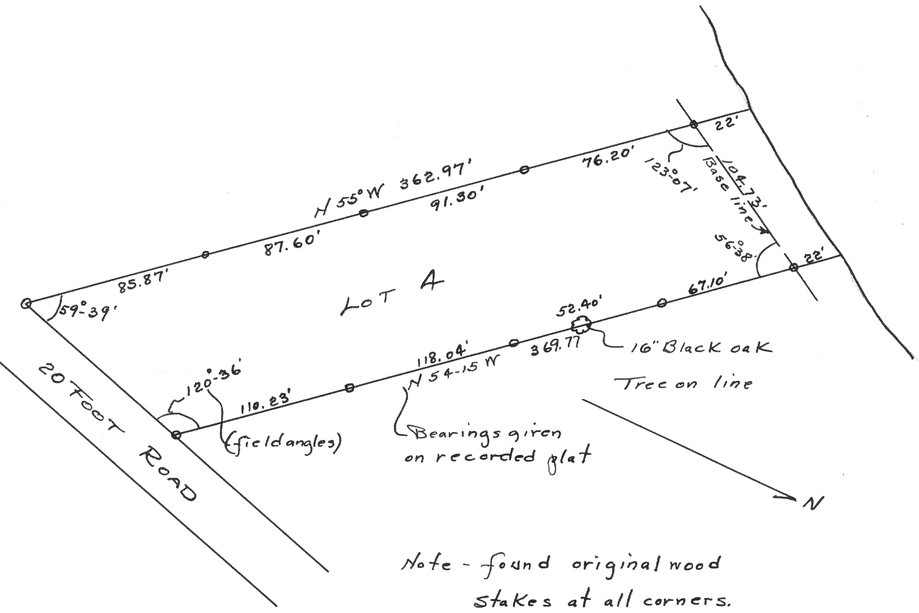

Note - found original wood stakes at all corners.

Plat of survey of Lot 4 of Kings Park Subdivision, located in fractional Section 17, T47N R17E.

Dec. 1942

Lloyd L. Jensen
County Surveyor