

#1339

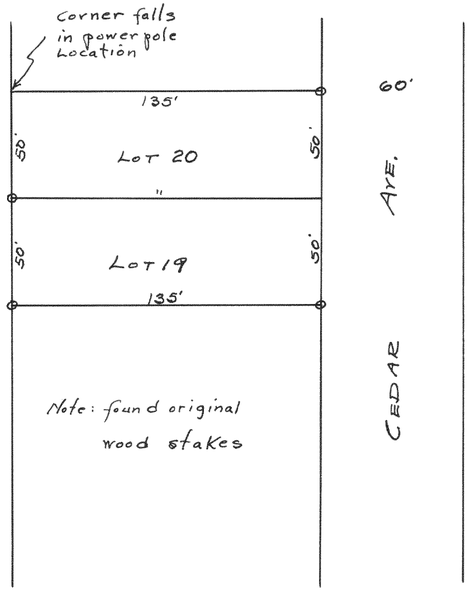

Plat of survey of Lots 19 and 20 of Block 13 of Miramar Subdivision, located in Sections 10 and 11, T47R18E.

Aug. 1942 Floyd S. Jensen County Surveyor

#1340

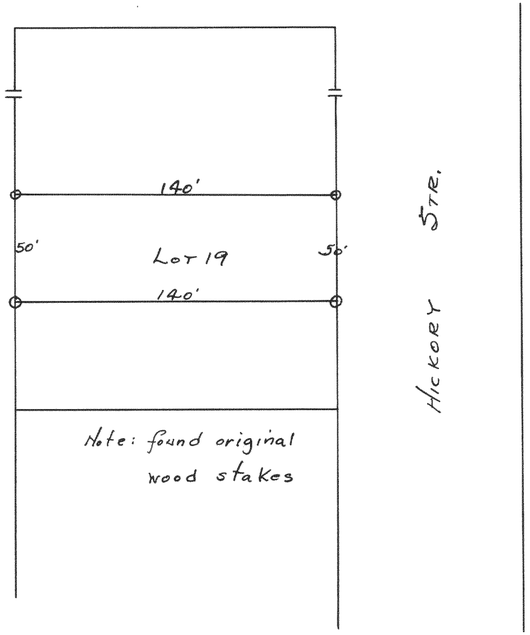

Plat of survey of Lots 19 ~~and~~ of Block 12 of Miramar Subd., located in Sections 10 and 11, T47R18E.

Aug. 1942 Floyd S. Jensen County Surveyor