#1341

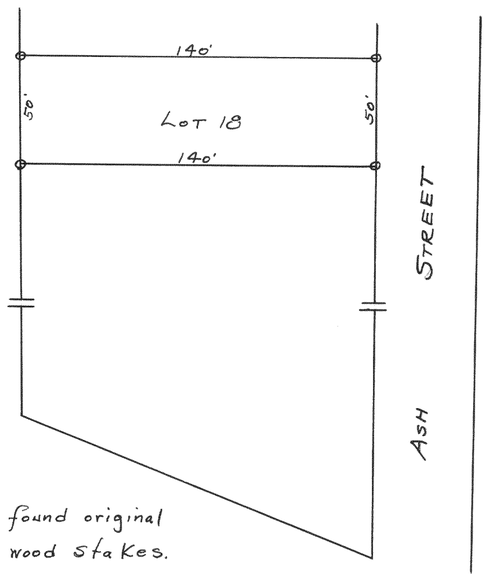

Note: found original wood stakes.

Plat of survey of lot 18 of Block 8 of Miramar Subd. located in Sections 10 and 11 T4N R18E.

Aug. 1942 Floyd L. Jensen County Surveyor

#1342

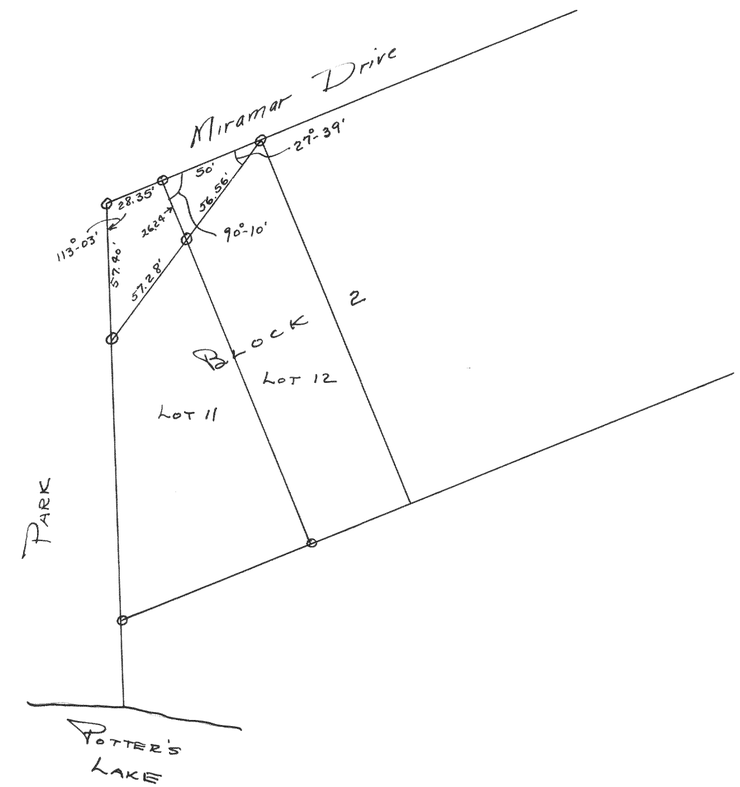

Plat of survey of part of Lot 11 and 12 of Block 2 of Miramar Subd., located in Sections 10 and 11, T4N R18E.

Aug. 1942 Floyd L. Jensen County Surveyor