
#1343

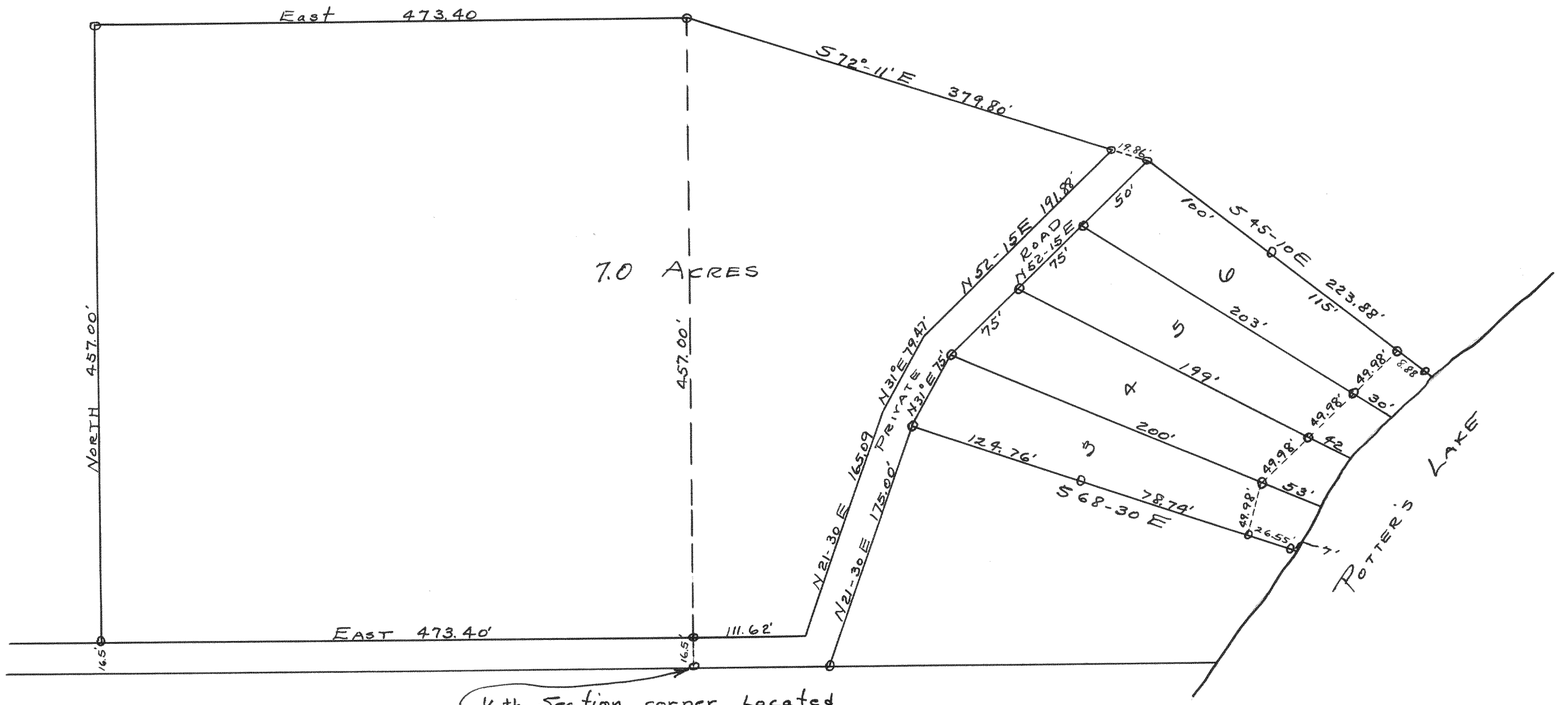

1/8 th. Section corner Located on the West line of the South east 1/4 of Section 10, T4N R18E

Plat of survey of land in Section 10, T4N R18E and of Lots 3, 4, 5 and 6 of Sykes Subdivision, Walworth County Wisconsin

Aug. 1942

Lloyd L. Jensen
County Surveyor