
#1344

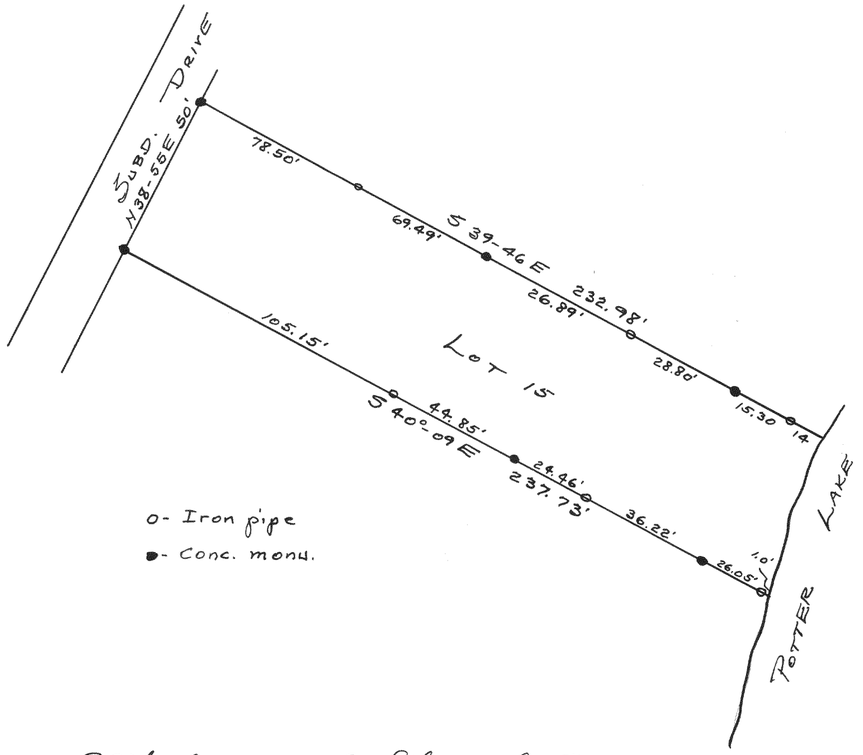


o- Iron pipe


●- Conc. mons.

Plat of survey of Lot 15 of Spleas Subdivision, located in Section 10, T4N R18E of Walworth County Wisconsin.

Aug. 1942

Lloyd L. Jensen
County Surveyor

#1345

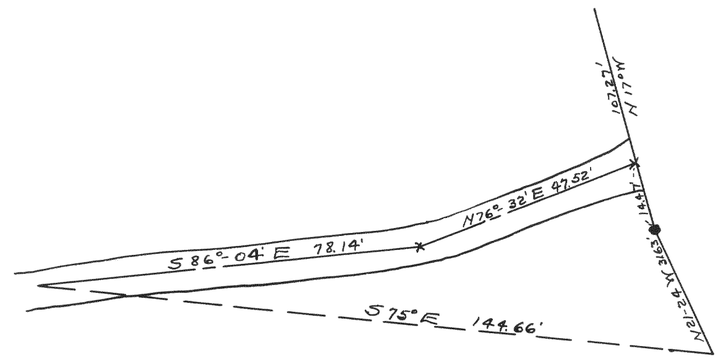


Plat of survey of road change on Lippert and Rowe property located in the Northeast fractional 1/4 of Section 9, T4N R18E.

July 16, 1942

Lloyd L. Jensen
County Surveyor