
#1348

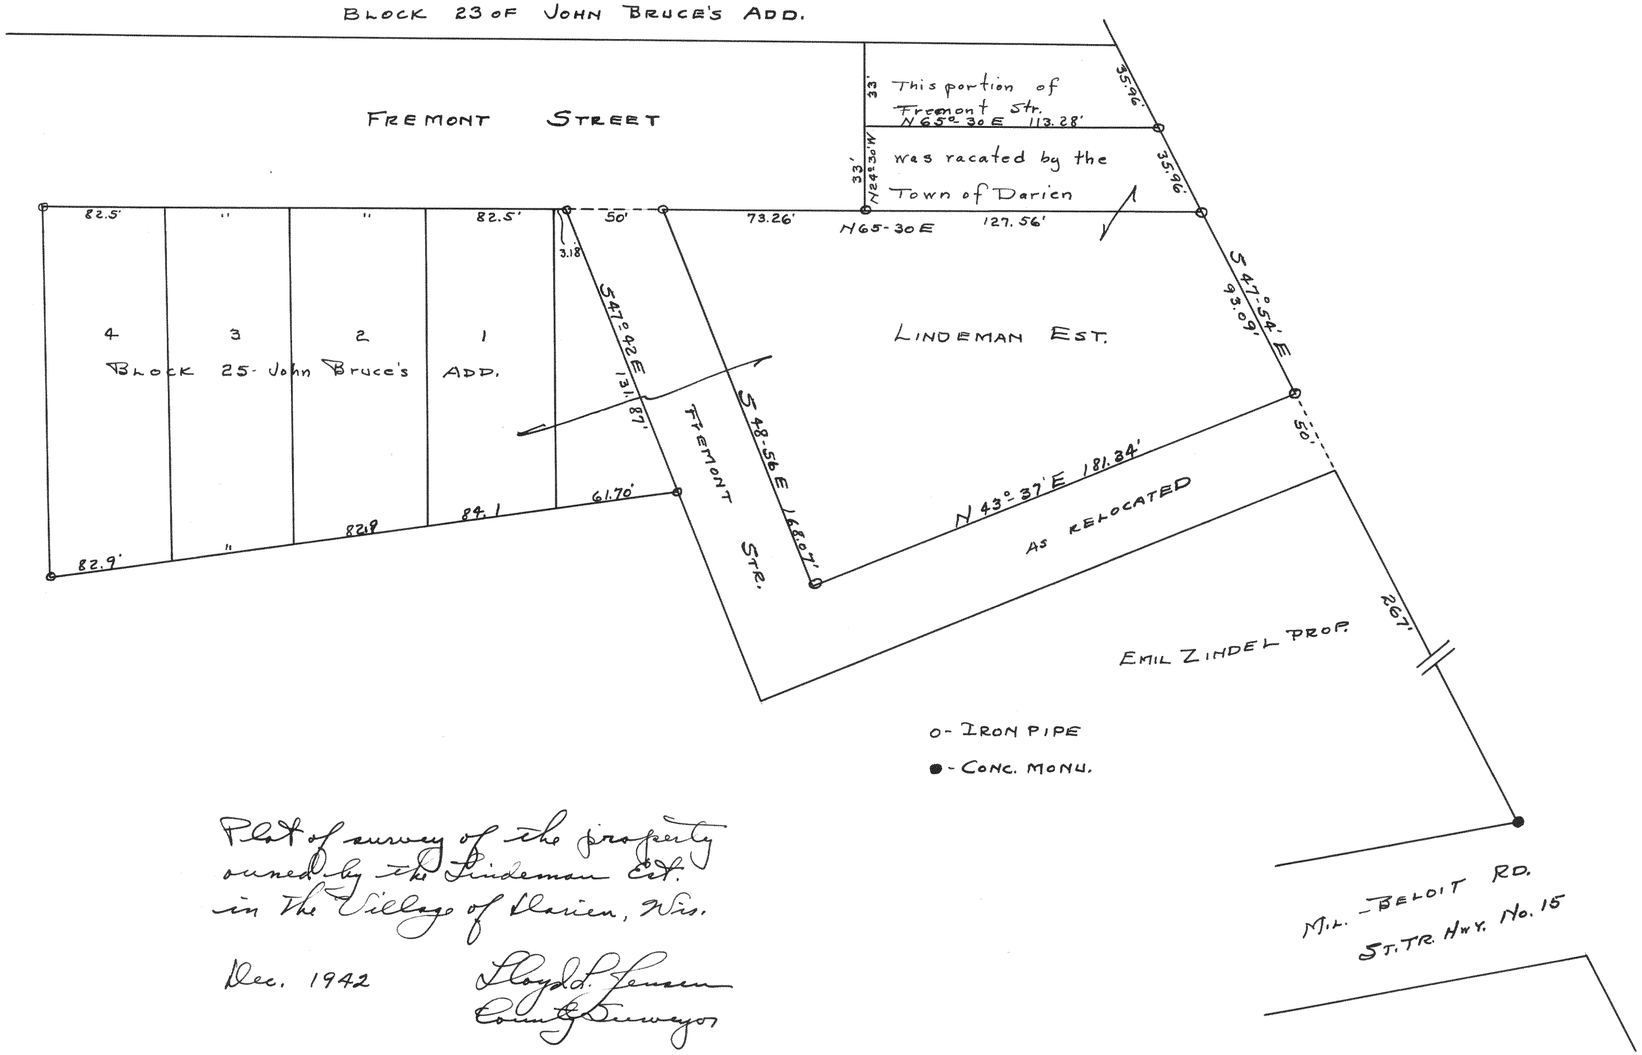

Plat of survey of the property owned by the Lindeman Est. in the Village of Darien, Wis.

Dec. 1942

Lloyd L. Jensen
County Surveyor