#1351


CENTER STR. N56°E 66'



Plat of survey of the South 50 feet of Lots 7 and 8 of Block 4 of Converse's Subdivision, City of Delavan, Wisconsin.

Jan. 1943 Lloyd L. Jensen
County Surveyor

#1352

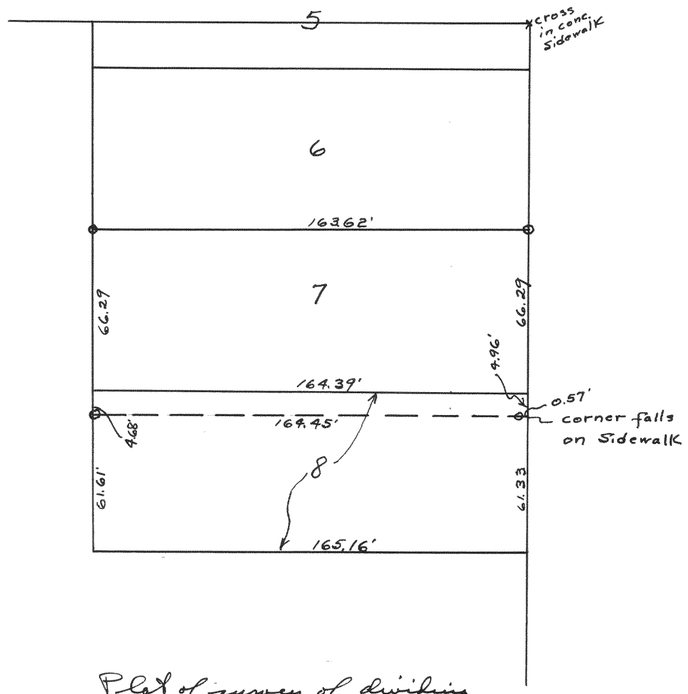

Plat of survey of dividing line in Lot 8 of Block 2 of J. B. Reynolds' Add. to the City of Delavan.

June 6, 1942 Lloyd L. Jensen
County Surveyor