
#2618

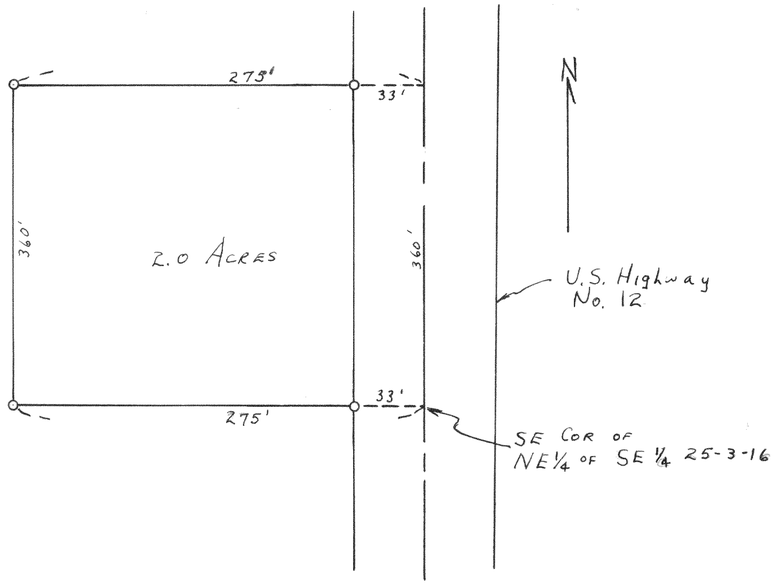


Plat of survey of a parcel of land located in the NE ¼ of the SE ¼ of Section 25, T3N R16E

Nov. 24, 1952

Lloyd L. Jensen
County Surveyor C.R.S.

#2619

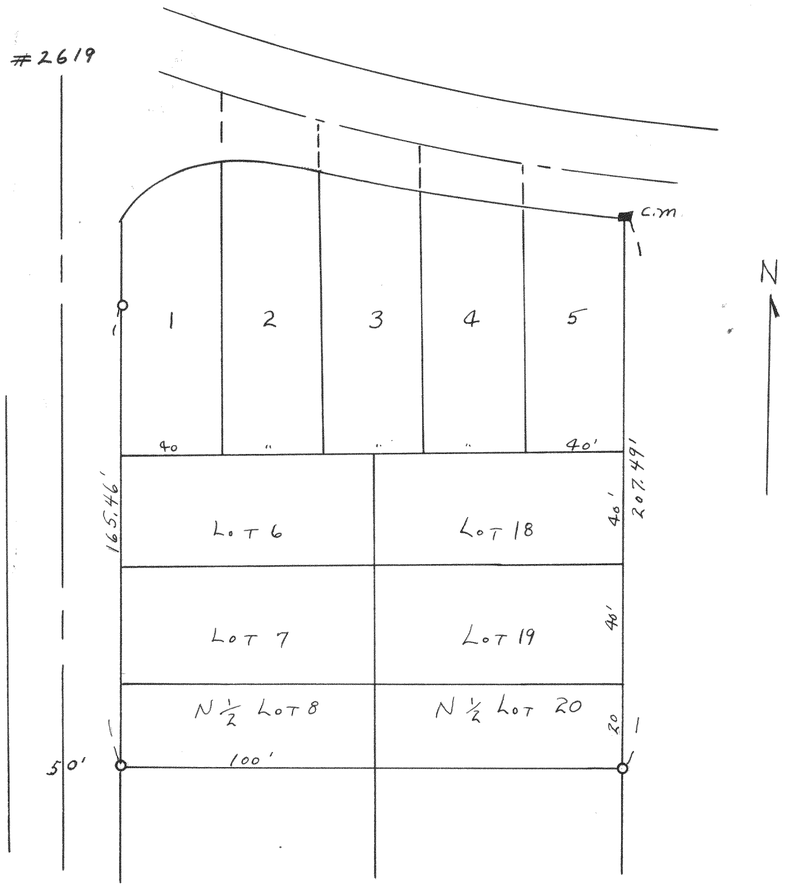

Plat of survey of Lots 1, 2, 3, 4, 5, 6, 7, N ½ Lot 8, 18, 19 and the N ½ of Lot 20 of Block 18 of the Second Map of Interlaken Subdivision, located in Section 11, T3N R16E

Dec. 6, 1952

Lloyd L. Jensen
County Surveyor C.R.S.