

2649

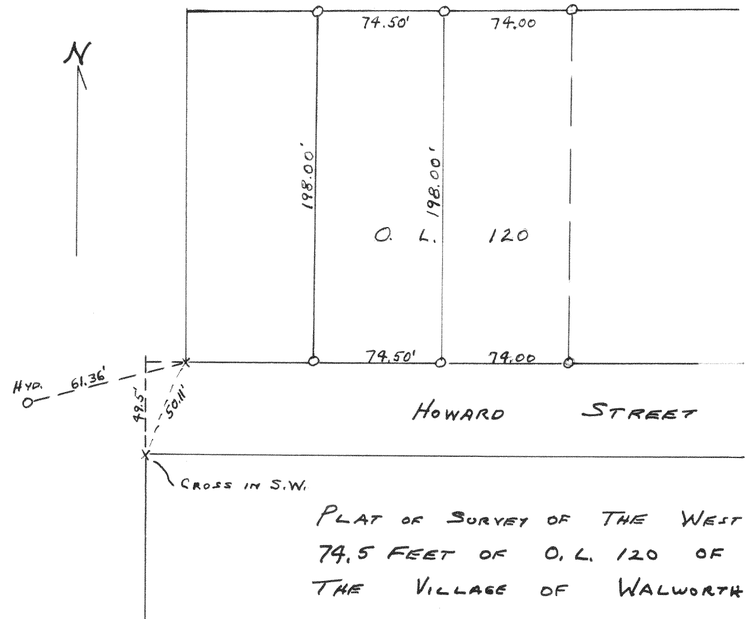

PLAT OF SURVEY OF THE WEST 74.5 FEET OF O. L. 120 OF THE VILLAGE OF WALWORTH

1952 Lloyd L Jensen
COUNTY SURVEYOR

2650

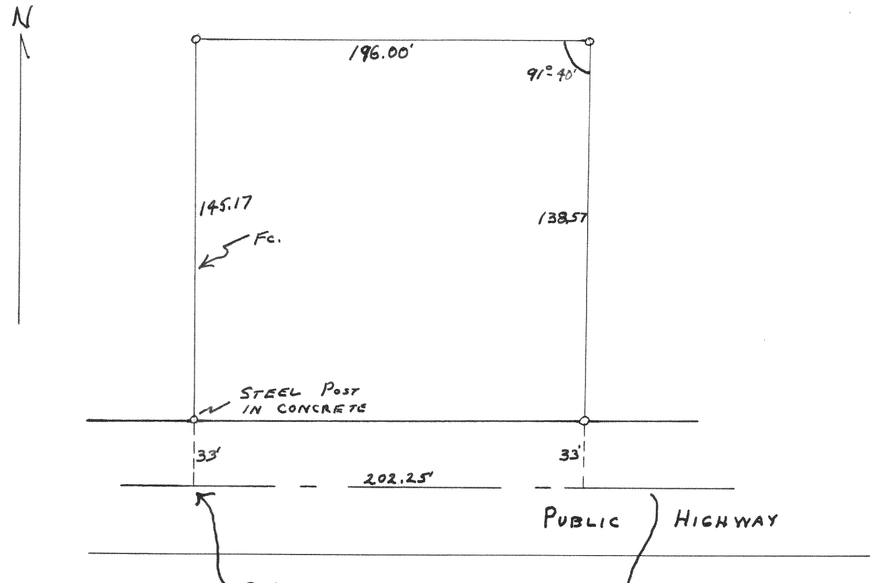


PLAT OF SURVEY OF A PARCEL OF LAND LOCATED IN THE E½ OF THE SOUTHEAST ¼ OF SECTION 13, T 4N, R 16 E.

Lloyd L Jensen
COUNTY SURVEYOR

NOV. 7, 1952

2651

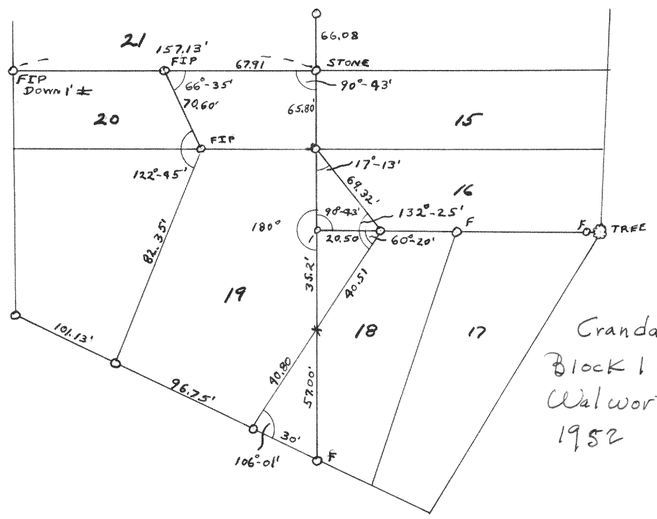

Crandall's & Swinney's Block 1 of Village of Walworth.
1952
Lloyd L Jensen
County Surveyor