

#3039

LOT 10 OF STEARNS & GEROULDS SUBDIVISION LOCATED IN FONTANA ON GENEVA LAKE, WISCONSIN
DEC. 1955

LLOYD L. JENSEN
COUNTY SURVEYOR

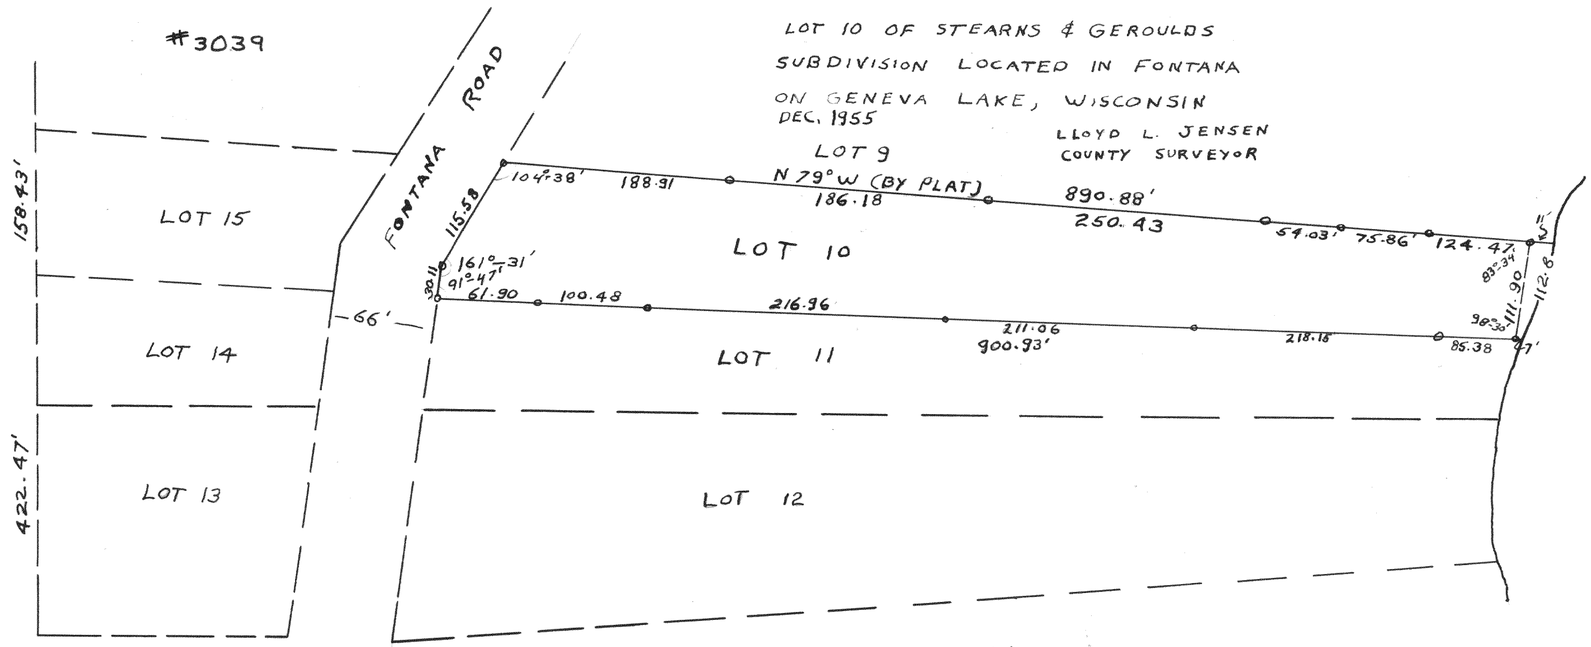

#3040

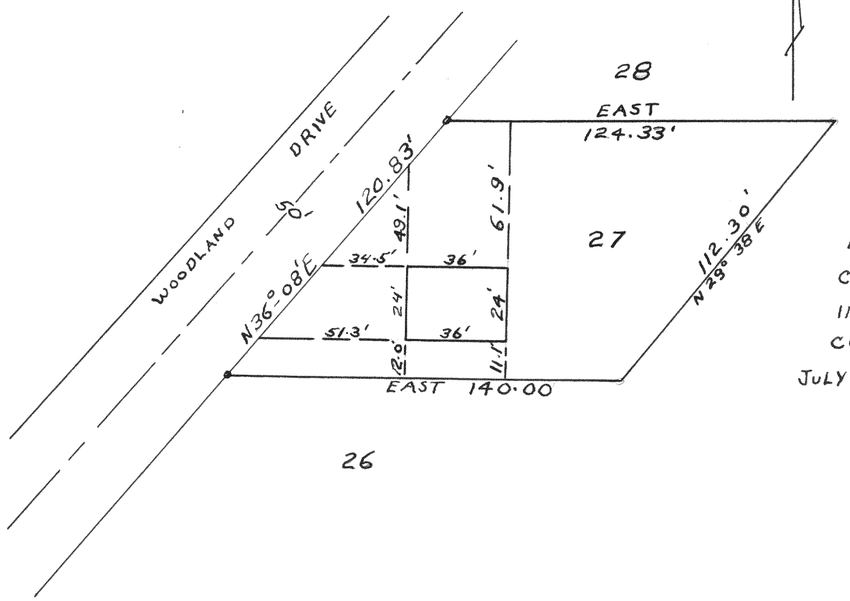

LOT 27 OF ADDITION "E" TO COUNTRY CLUB ESTATES LOCATED IN VILLAGE OF FONTANA, WALWORTH COUNTY, WISCONSIN

JULY 1955

LLOYD L. JENSEN
COUNTY SURVEYOR