

#3048

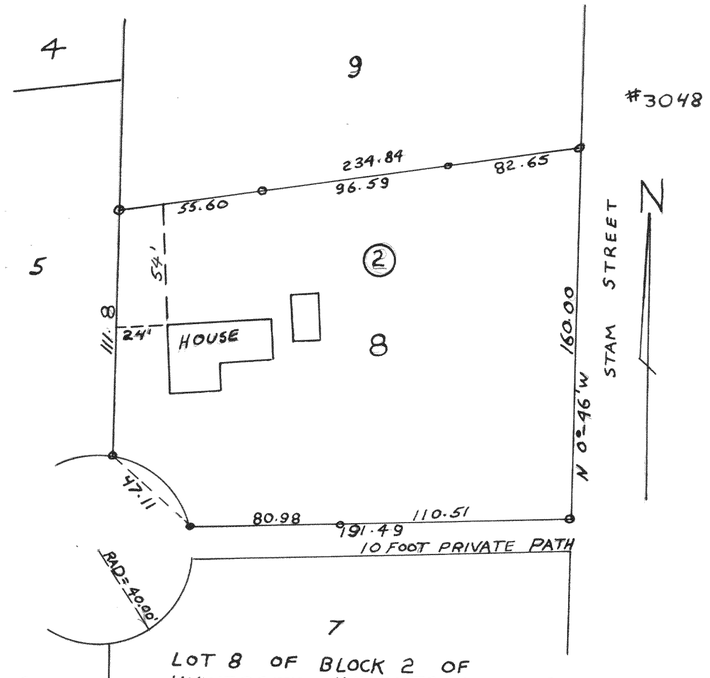

LOT 8 OF BLOCK 2 OF UNIVERSITY HEIGHTS LOCATED IN THE VILLAGE OF WILLIAMS BAY WALWORTH COUNTY, WISCONSIN

FEB., 1955 LLOYD L. JENSEN COUNTY SURVEYOR


#3049

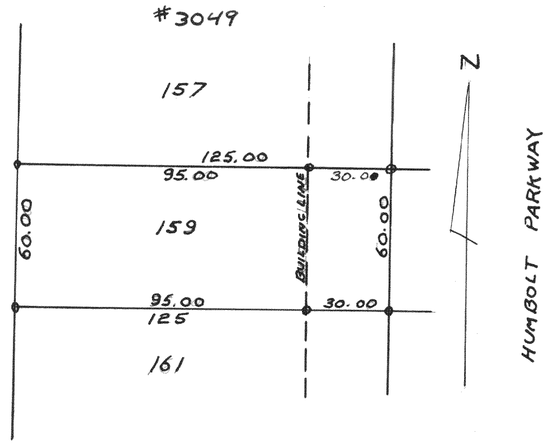

LOT 159 OF THE ORIGINAL PLAT OF CEDAR POINT PARK LOCATED IN THE VILLAGE OF WILLIAMS BAY, WALWORTH COUNTY, WISCONSIN.

SEPT., 1955 LLOYD L. JENSEN COUNTY SURVEYOR

#3050

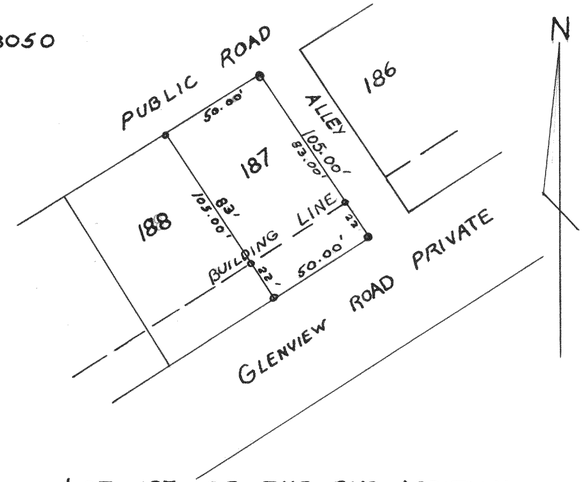


LOT 187 OF THE 2ND ADDITION TO CEDAR POINT PARK LOCATED IN THE VILLAGE OF WILLIAMS BAY WALWORTH COUNTY, WISC.

LLOYD JENSEN COUNTY SURVEYOR

OCT. 1955

#3051

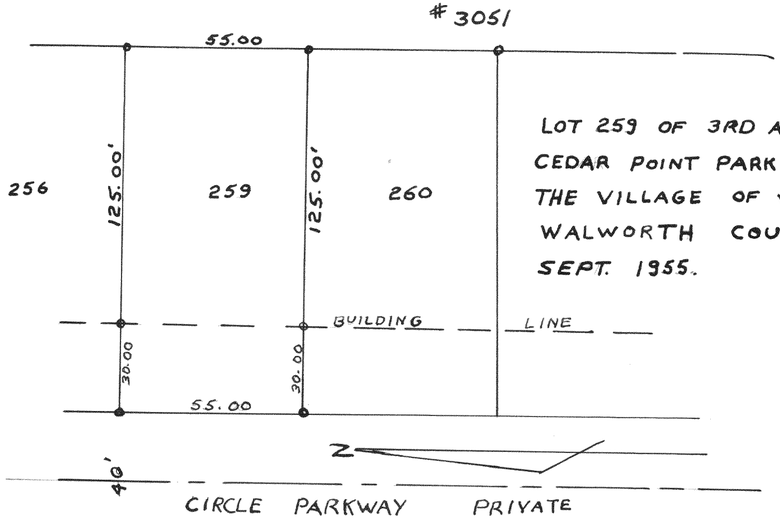

LOT 259 OF 3RD ADDITION TO CEDAR POINT PARK LOCATED IN THE VILLAGE OF WILLIAMS BAY, WALWORTH COUNTY, WISCONSIN

SEPT. 1955. LLOYD L. JENSEN COUNTY SURVEYOR