

#3067

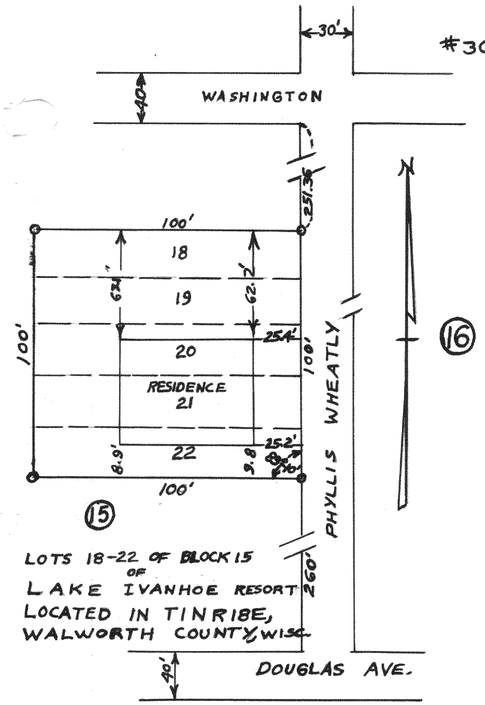

LOTS 18-22 OF BLOCK 15 OF LAKE IVANHOE RESORT LOCATED IN TINRIBE, WALWORTH COUNTY, WISC.

LLOYD L. JENSEN
COUNTY SURVEYOR
OCT. 27, 1955


#3068

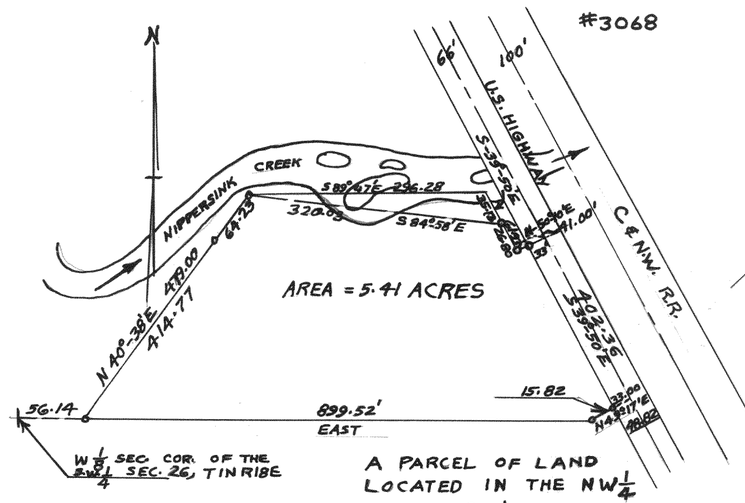

A PARCEL OF LAND LOCATED IN THE NW1/4 OF THE SW1/4 OF SECTION 26, TINRIBE, WALWORTH COUNTY, WISCONSIN.


LLOYD L. JENSEN
COUNTY SURVEYOR

#3069

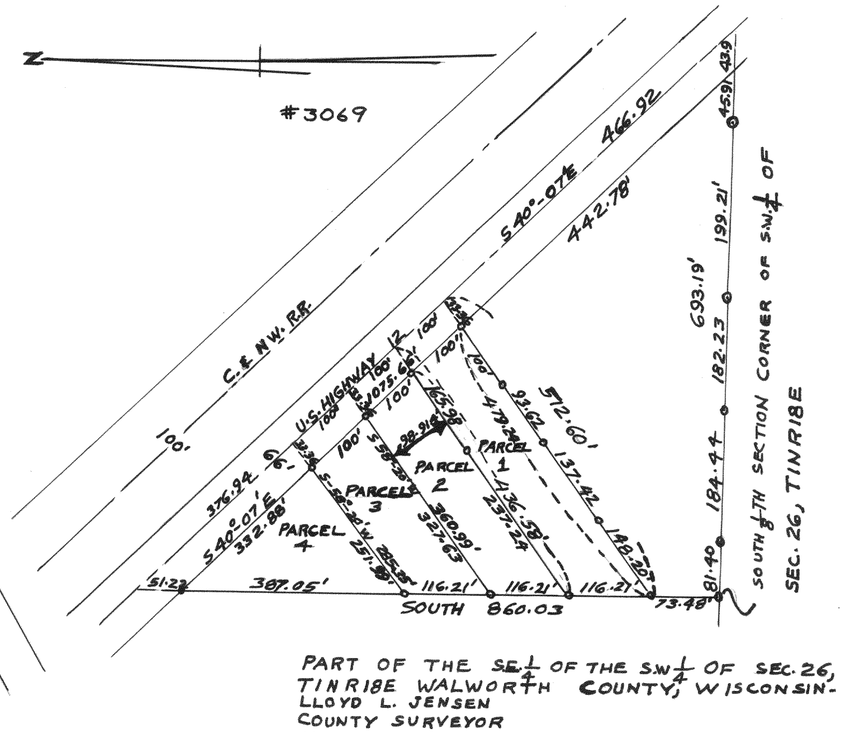


PART OF THE SE.1/4 OF THE S.W.1/4 OF SEC. 26, TINRIBE WALWORTH COUNTY, WISCONSIN.
LLOYD L. JENSEN
COUNTY SURVEYOR
NOV. 9, 1955

#3070

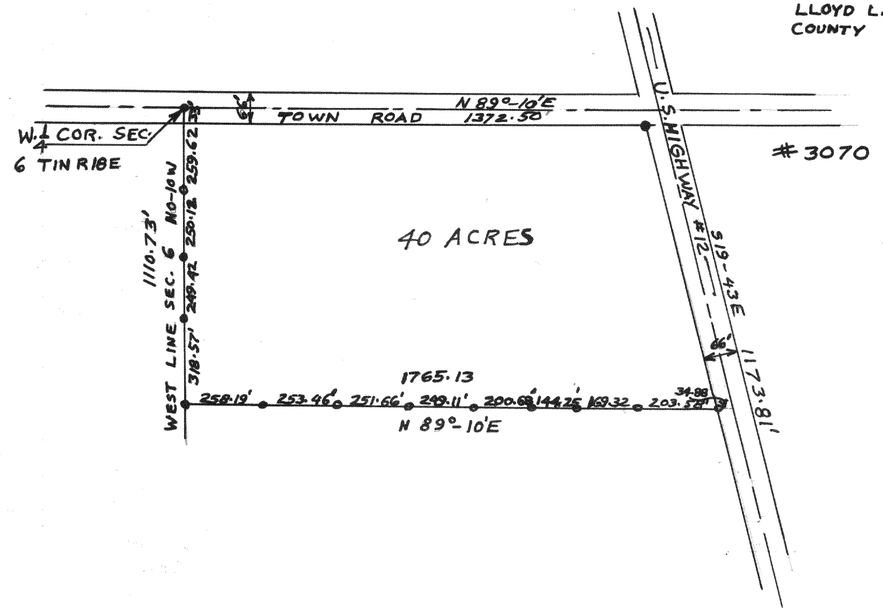

#3071

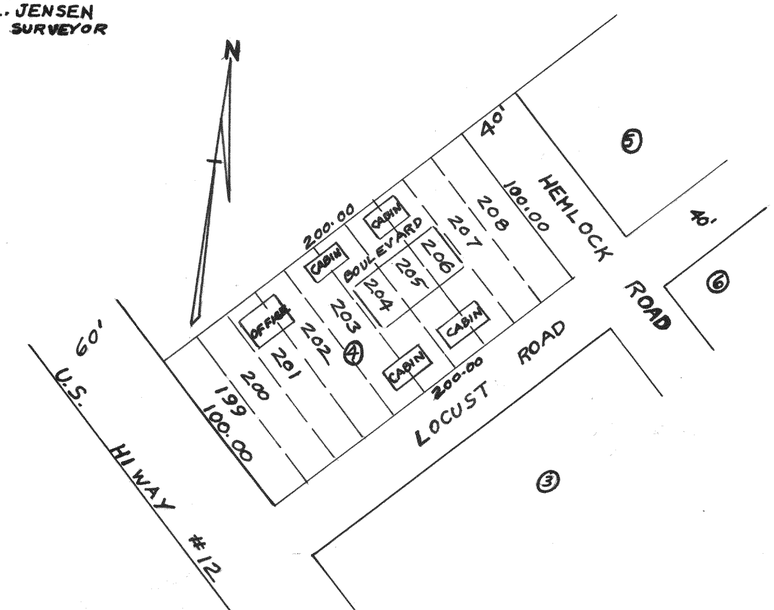

LOTS 199-208, BLOCK 4 PELL LAKE LOCATED IN TINRIBE, WALWORTH CO., WISCONSIN
LLOYD L. JENSEN
COUNTY SURVEYOR
FEB. 1955