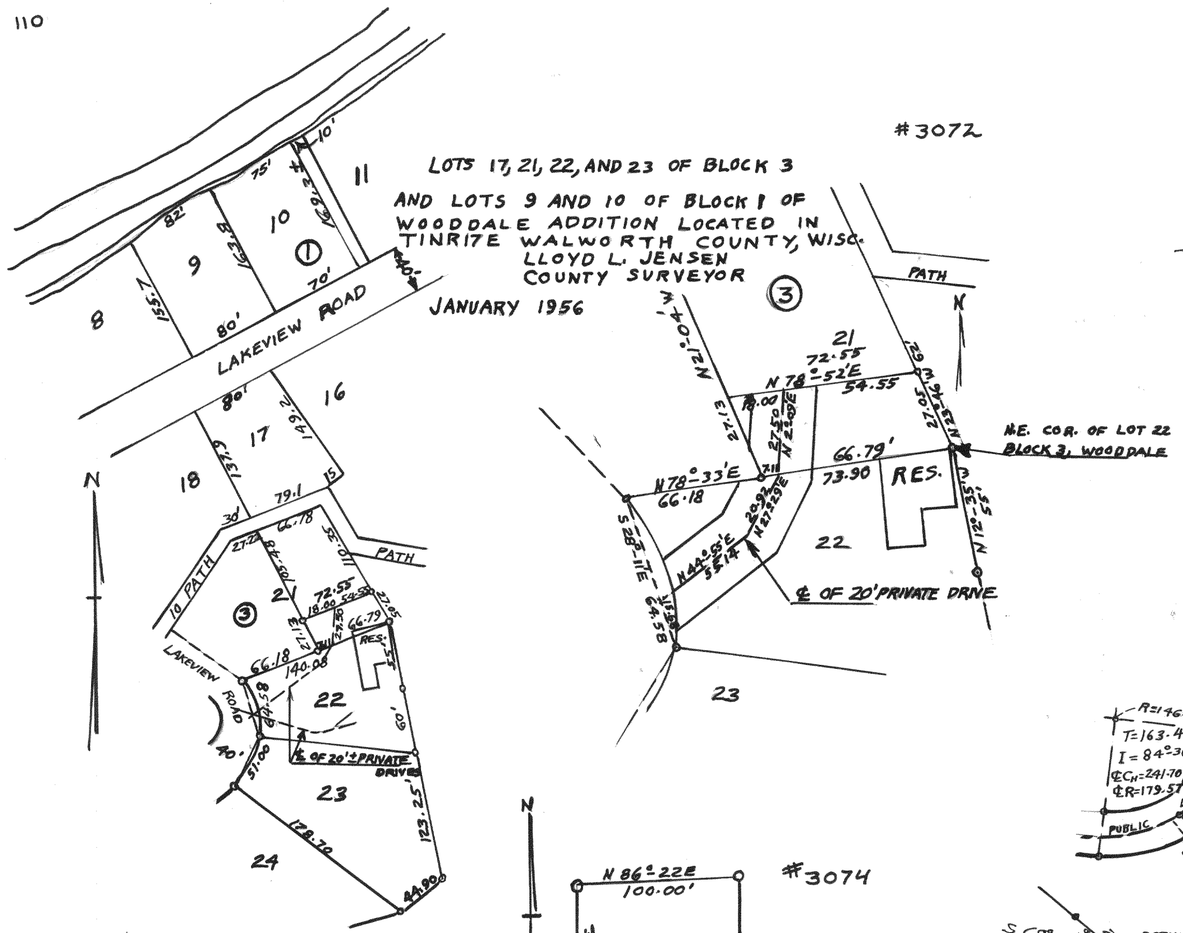

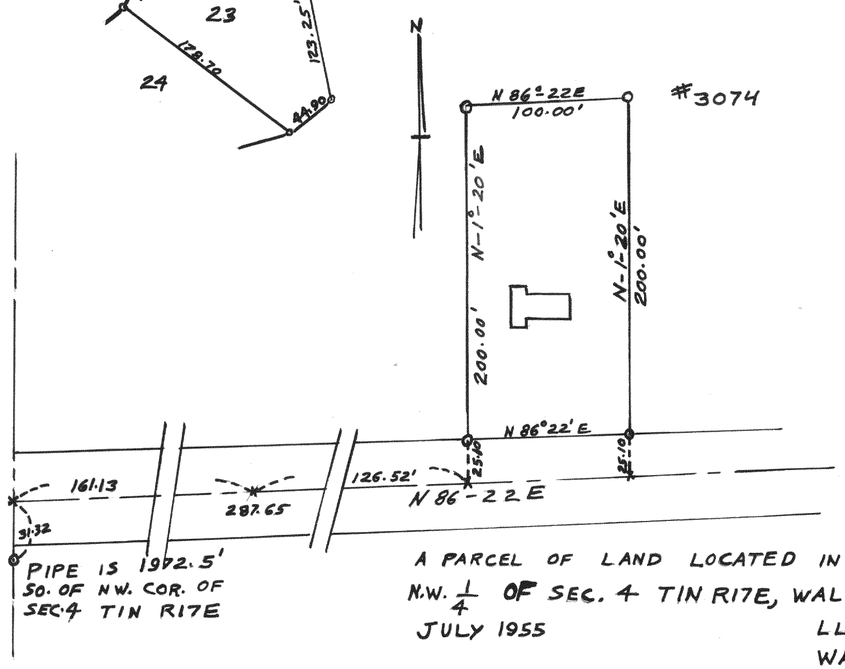

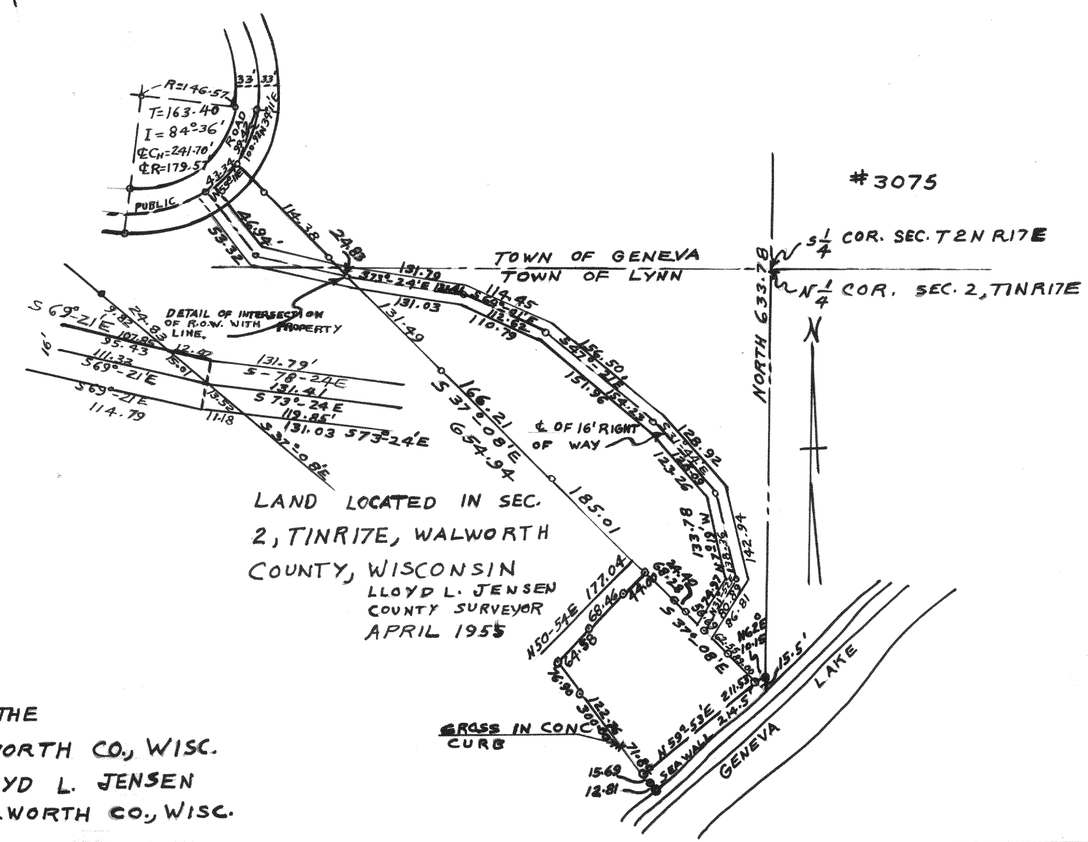

A PARCEL OF LAND LOCATED IN THE N.W. 1/4 OF SEC. 4 T1N R17E, WALWORTH CO., WISC.
JULY 1955
LLOYD L. JENSEN
WALWORTH CO., WISC.