

#3077

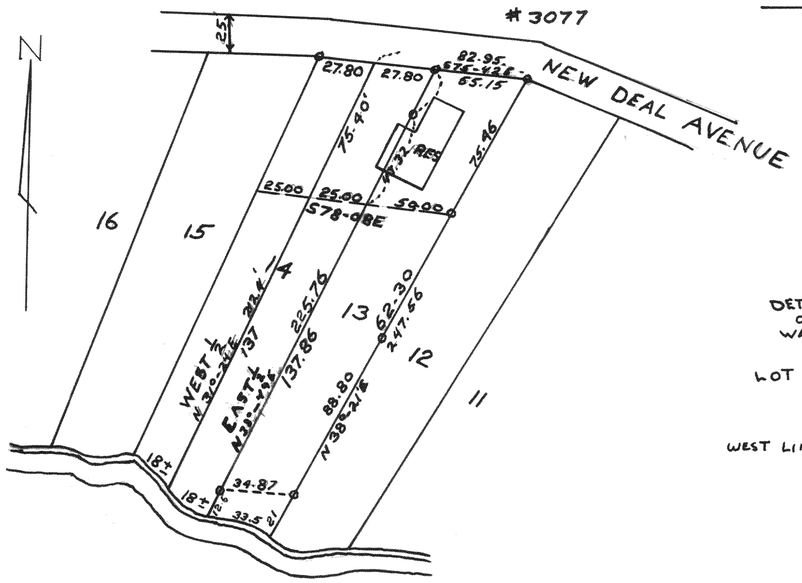


LOT 13 & 14 OF FREUCK'S SUBDIVISION LOCATED IN T4N R18E, WALWORTH COUNTY, WISCONSIN.

LLOYD L. JENSEN
COUNTY SURVEYOR
JAN. 1956

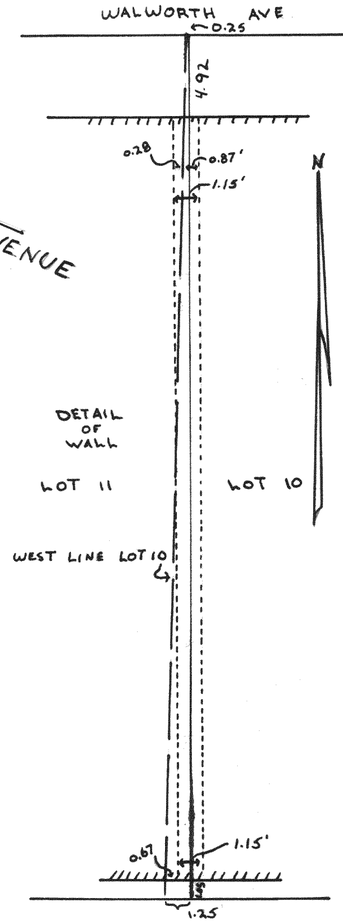


#3078

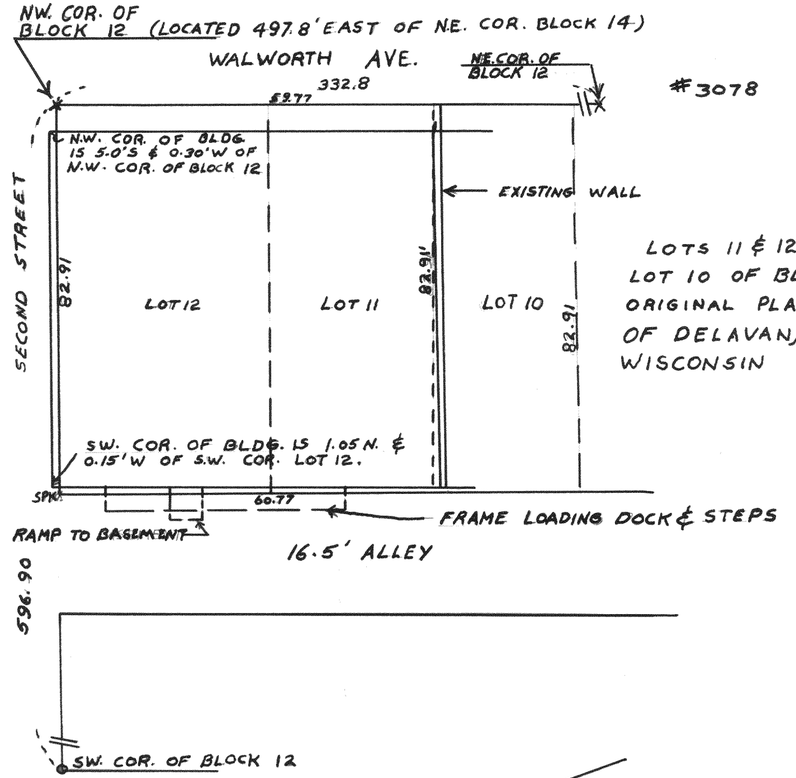

LOTS 11 & 12 AND PART OF LOT 10 OF BLOCK 12 OF THE ORIGINAL PLAT OF THE CITY OF DELAVAN, WALWORTH CO., WISCONSIN

LLOYD L. JENSEN
COUNTY SURVEYOR
MARCH 14/56


#3079

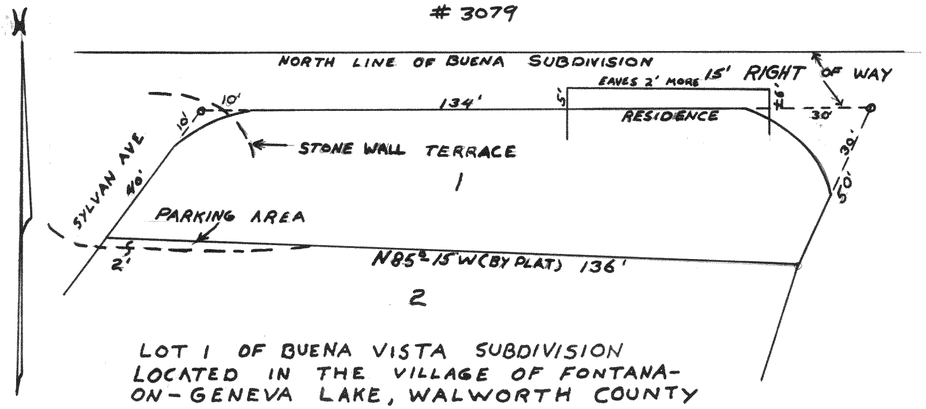

LOT 1 OF BUENA VISTA SUBDIVISION LOCATED IN THE VILLAGE OF FONTANA-ON-GENEVA LAKE, WALWORTH COUNTY WISC.
MARCH 1956

LLOYD L. JENSEN
COUNTY SURVEYOR

#3080

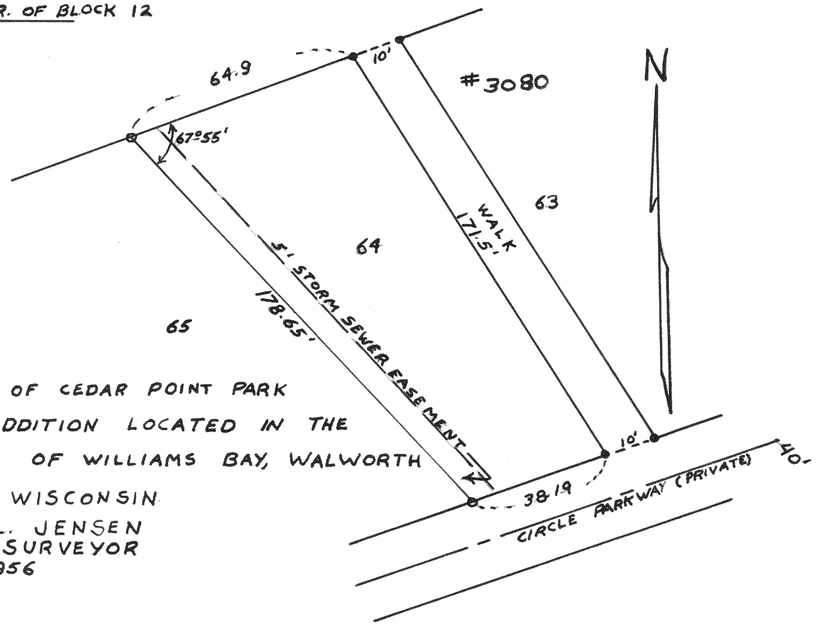

LOT 64 OF CEDAR POINT PARK FIRST ADDITION LOCATED IN THE VILLAGE OF WILLIAMS BAY, WALWORTH COUNTY WISCONSIN

LLOYD L. JENSEN
COUNTY SURVEYOR
MAR. 8, 1956