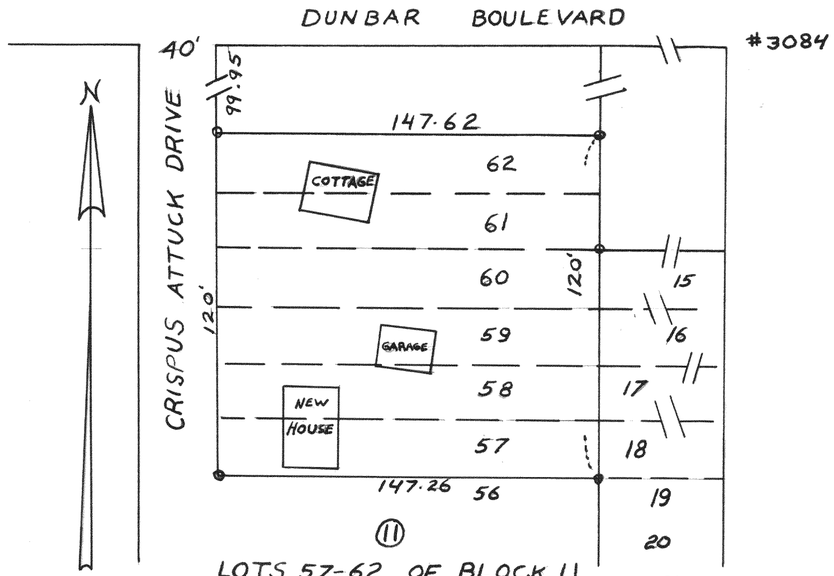

LOTS 57-62 OF BLOCK 11
OF LAKE IVANHOE RESORT
LOCATED IN T1NR18E, WALWORTH
COUNTY, WISCONSIN.
LLOYD L. JENSEN
COUNTY SURVEYOR MAR./55

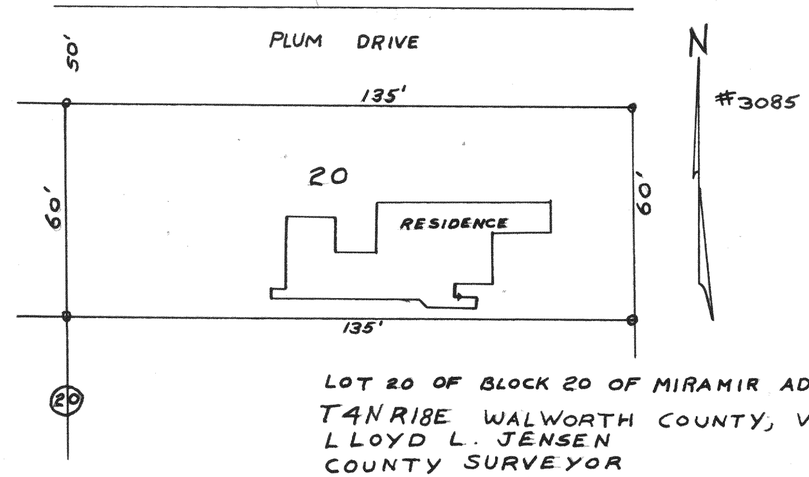

LOT 20 OF BLOCK 20 OF MIRAMIR ADDITION NO. 1
T4N R18E WALWORTH COUNTY, WISCONSIN
LLOYD L. JENSEN
COUNTY SURVEYOR
JUNE 1955

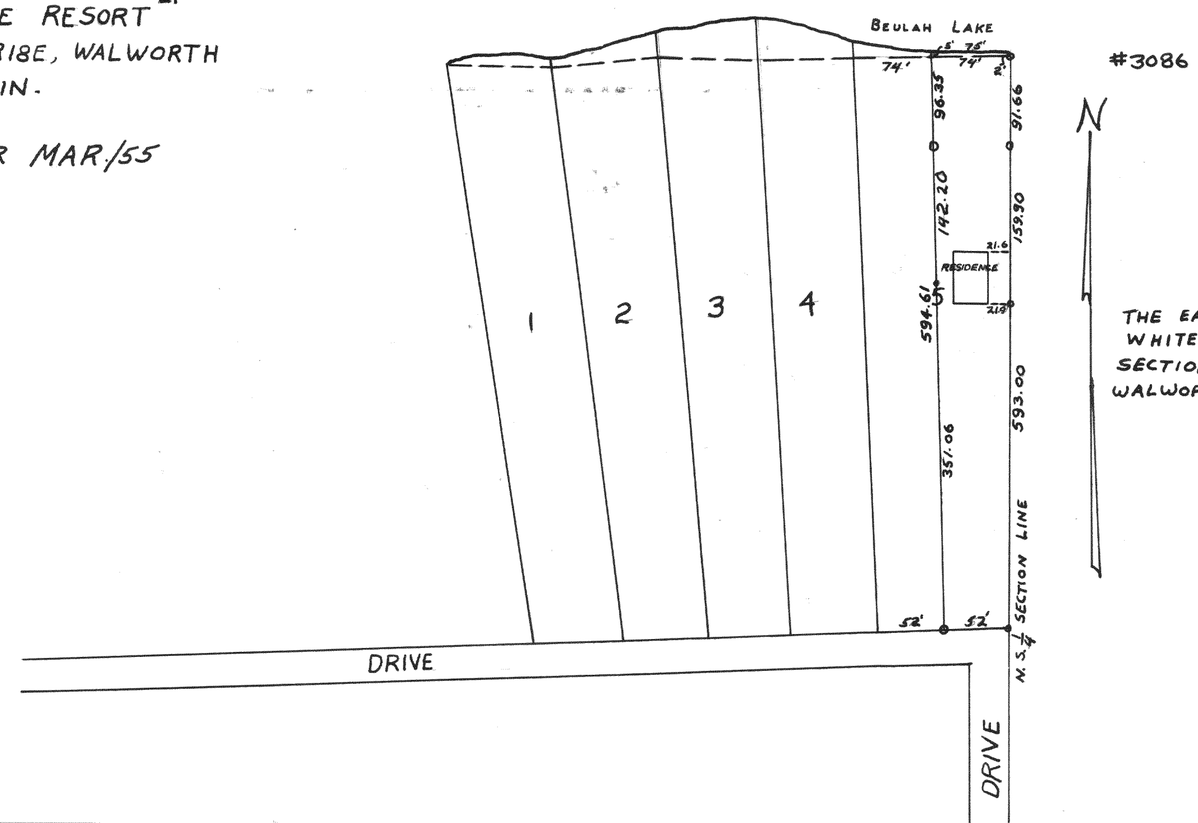

THE EAST HALF OF LOT 5 OF
WHITE'S SECOND SUBDIVISION,
SECTION 17, T4 N, R18E
WALWORTH COUNTY, WISCONSIN

LLOYD L. JENSEN
COUNTY SURVEYOR
APRIL 1, 1955