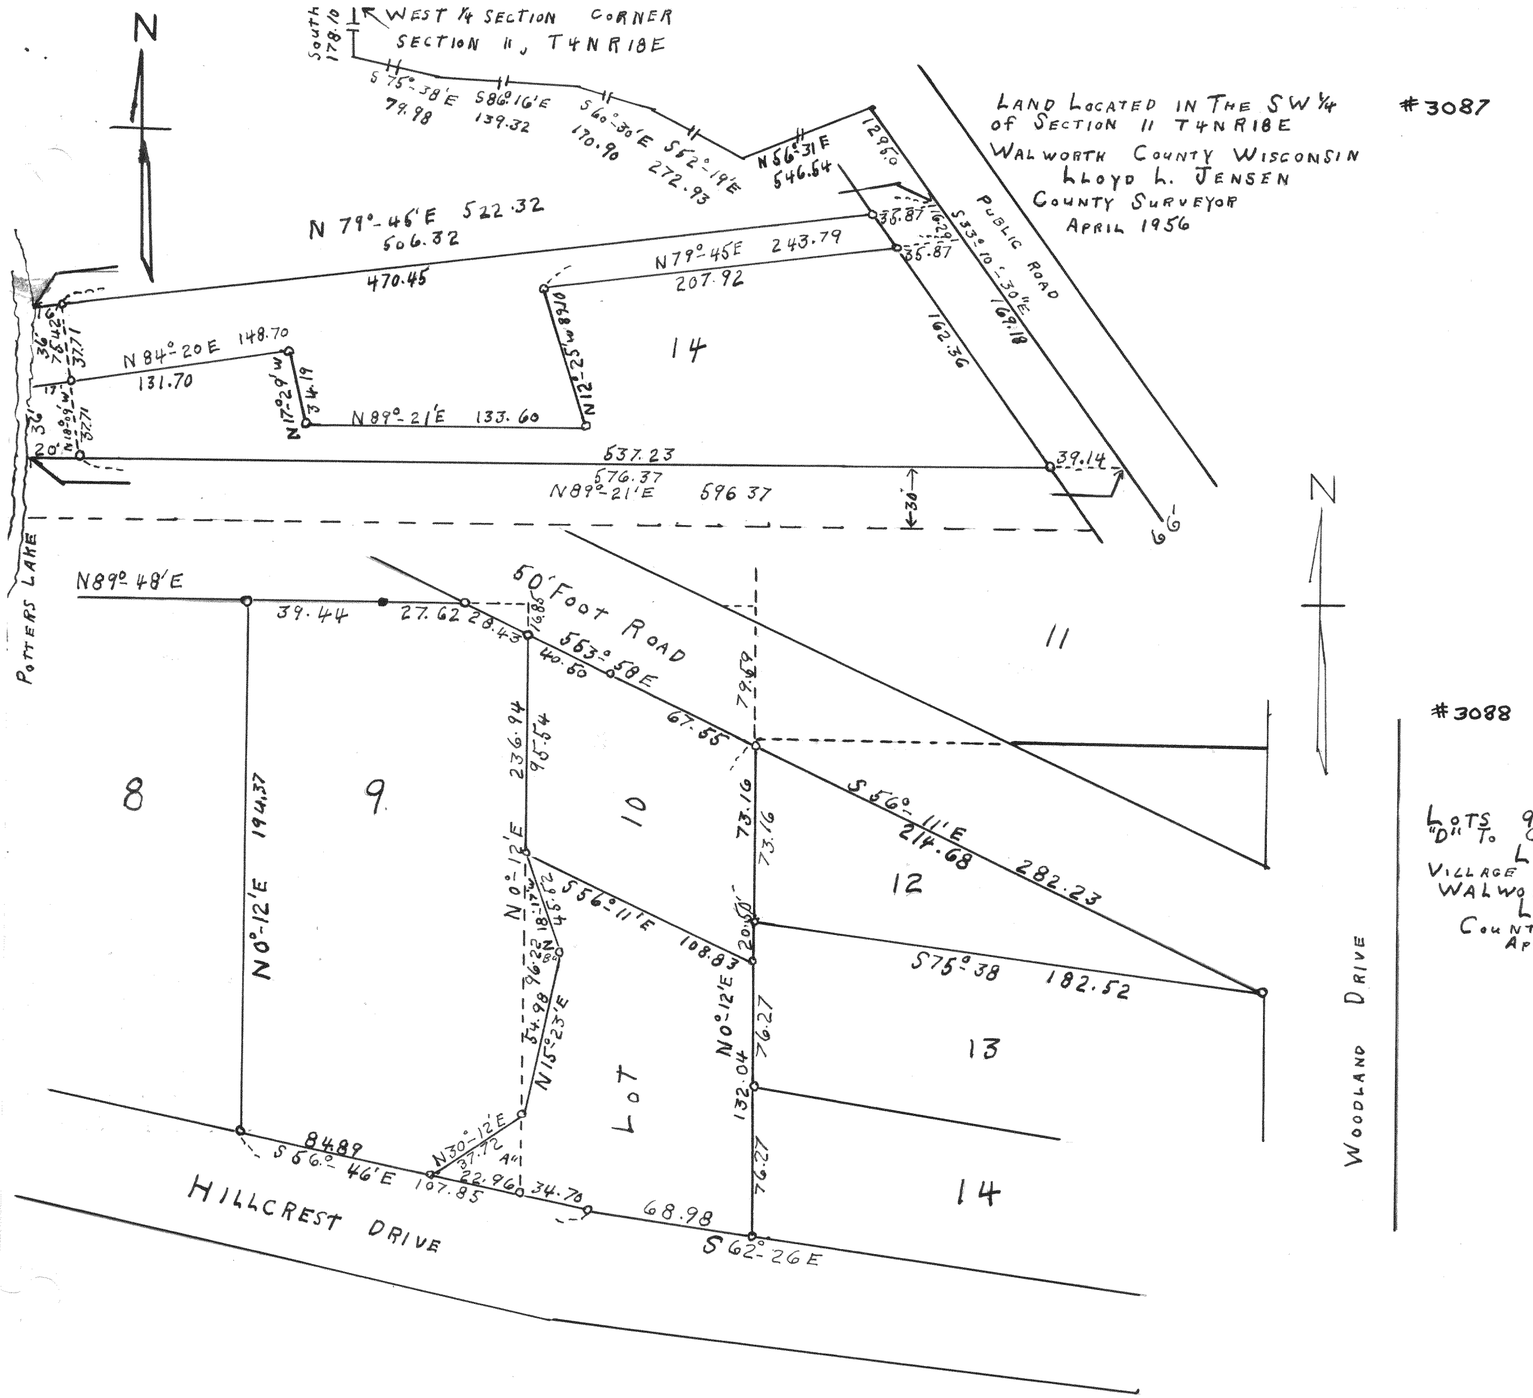

LAND LOCATED IN THE SW ¼
of SECTION 11 T4NR18E
WALWORTH COUNTY WISCONSIN
LLOYD L. JENSEN
COUNTY SURVEYOR
APRIL 1956

#3087

#3088

LOTS 9 AND 10 of ADDITION
"D" To COUNTRY CLUB ESTATES
LOCATED IN THE
VILLAGE of FONTANA ON GENEVA LAKE
WALWORTH COUNTY WISCONSIN
LLOYD L. JENSEN
COUNTY SURVEYOR
APRIL 1956