
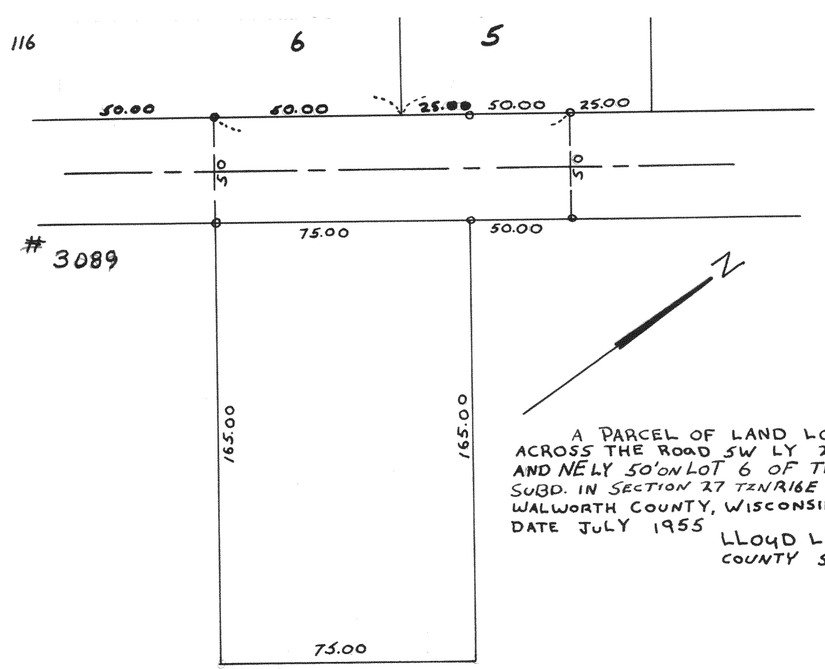


A PARCEL OF LAND LOCATED
ACROSS THE ROAD SW LY 25' ON LOT 5
AND NELY 50' ON LOT 6 OF THE HARRINGTON
SUBD. IN SECTION 27 T2NR16E
WALWORTH COUNTY, WISCONSIN
DATE JULY 1955


LLOYD L. JENSEN
COUNTY SURVEYOR

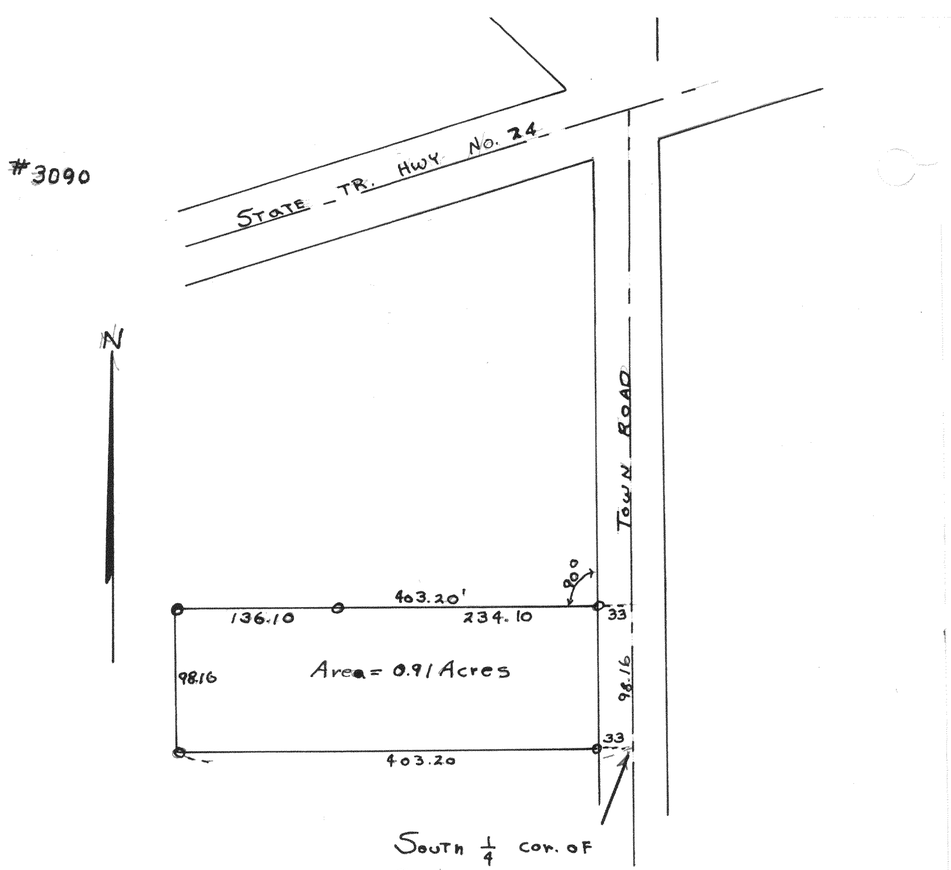

Plat of Survey of Additinal
Land for Stone School

Lloyd L. Jensen
County Surveyor

June 1956

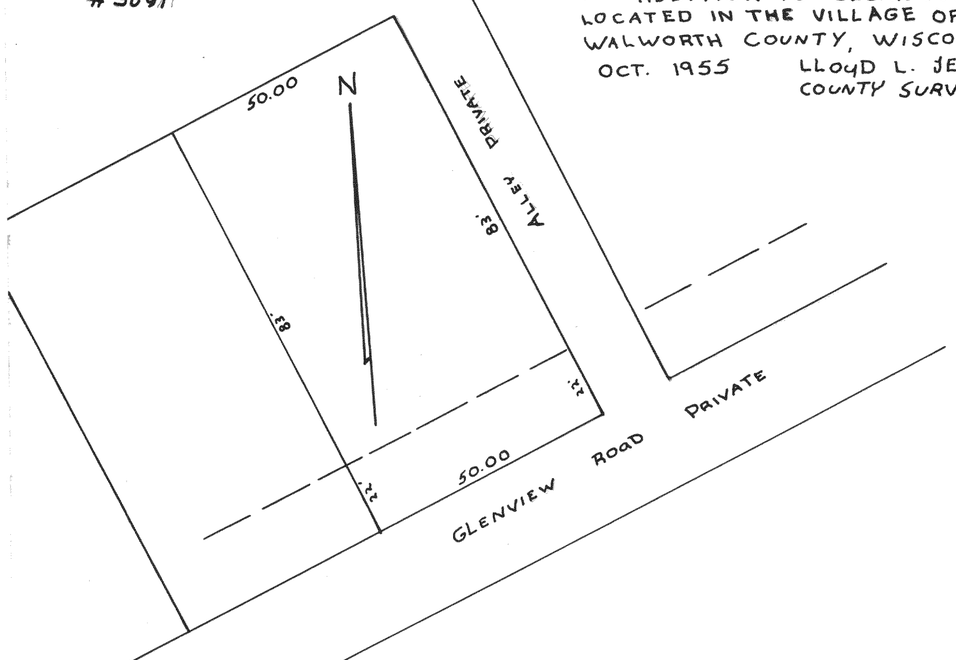

LOT 187 OF THE

2ND ADDITION TO CEDAR POINT PARK
LOCATED IN THE VILLAGE OF WILLIAMS BAY
WALWORTH COUNTY, WISCONSIN
OCT. 1955

LLOYD L. JENSEN
COUNTY SURVEYOR