

#3096

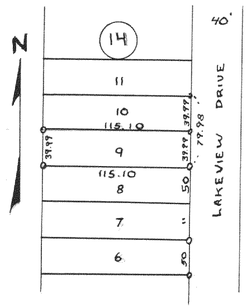


PLAT OF SURVEY OF LOT 9
BLOCK 14 SUNSET HILLS
WALWORTH COUNTY WISCONSIN
AUGUST 1955 LLOYD L JENSEN
SURVEYOR

#3097

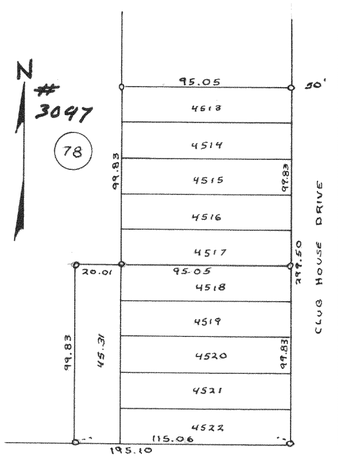


PLAT OF SURVEY OF LOTS
4513 - 4522 & 4537 BLOCK
78 LAKE COMO BEACH
WALWORTH COUNTY WISCONSIN
AUGUST 1955 LLOYD L. JENSEN
SURVEYOR

#3098

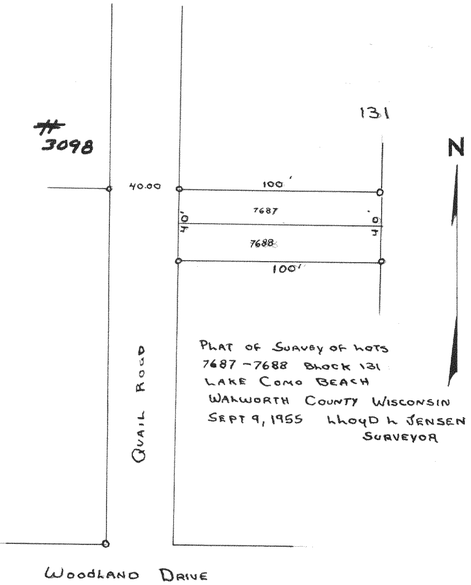


PLAT OF SURVEY OF LOTS
7687 - 7688 BLOCK 131
LAKE COMO BEACH
WALWORTH COUNTY WISCONSIN
SEPT 9, 1955 LLOYD L JENSEN
SURVEYOR

#3099

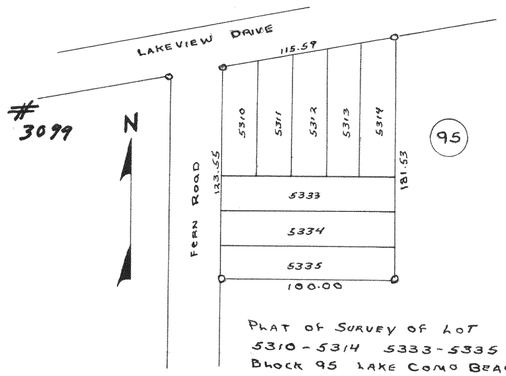


PLAT OF SURVEY OF LOT
5310 - 5314 5333 - 5335
BLOCK 95 LAKE COMO BEACH
WALWORTH COUNTY WISCONSIN
AUGUST 1955 LLOYD L. JENSEN
SURVEYOR

#3100

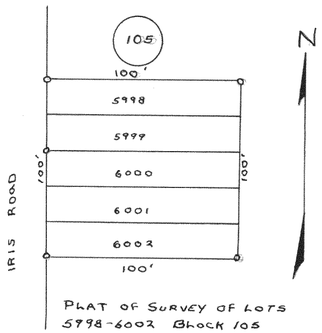

PLAT OF SURVEY OF LOTS
5998 - 6002 BLOCK 105
LAKE COMO BEACH WALWORTH
COUNTY WISCONSIN
SEPTEMBER 1955 LLOYD L JENSEN
SURVEYOR

#3101

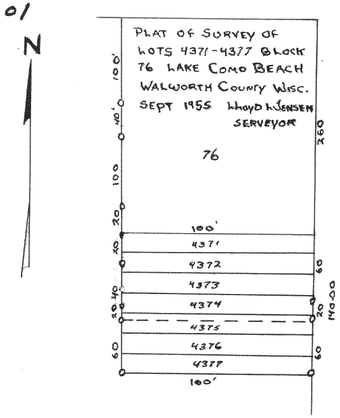

PLAT OF SURVEY OF
LOTS 4371 - 4377 BLOCK
76 LAKE COMO BEACH
WALWORTH COUNTY WISC.
SEPT 1955 LLOYD L. JENSEN
SERVEYOR

76