

#3120

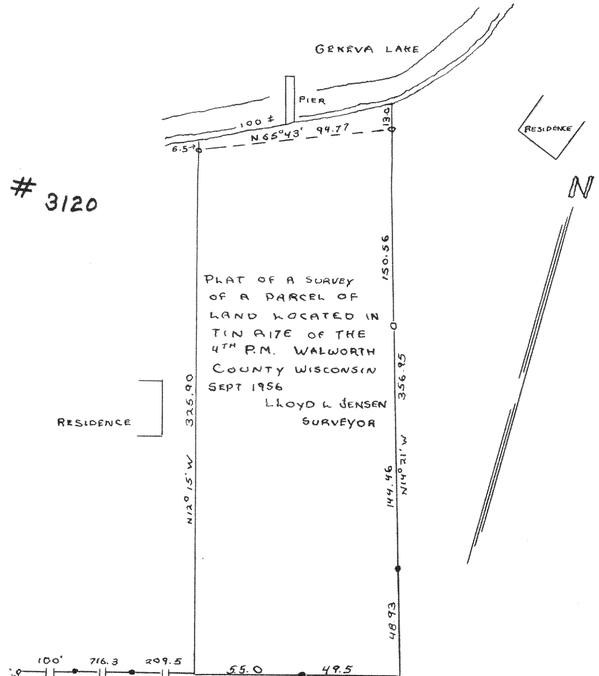


PLAT OF A SURVEY OF A PARCEL OF LAND LOCATED IN T1N R17E OF THE 4TH P.M. WALWORTH COUNTY WISCONSIN SEPT 1956
LLOYD L JENSEN
SURVEYOR

#3121

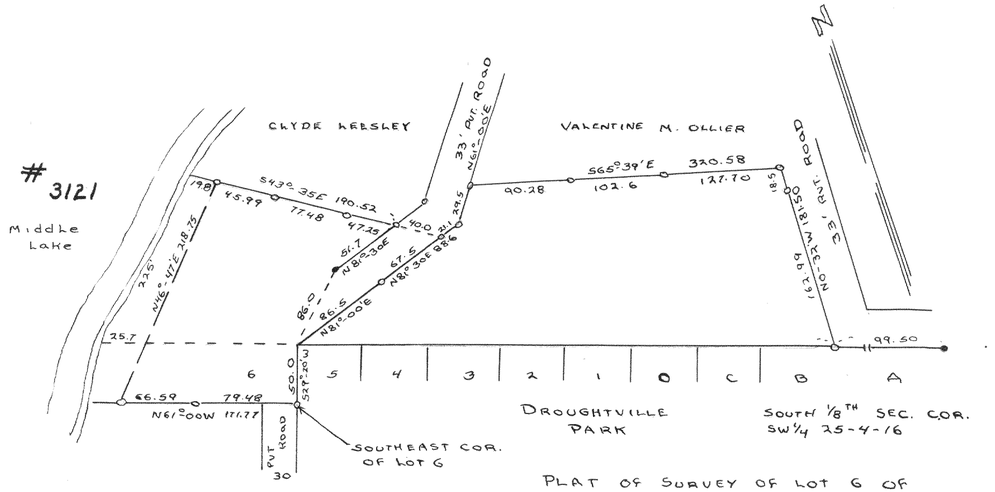

PLAT OF SURVEY OF LOT 6 OF DROUGHTVILLE PARK AND LAND IN SW1/4 SECTION 25-4-16 WALWORTH COUNTY, WISCONSIN
SEPT 1956
LLOYD L JENSEN
SURVEYOR


#3122

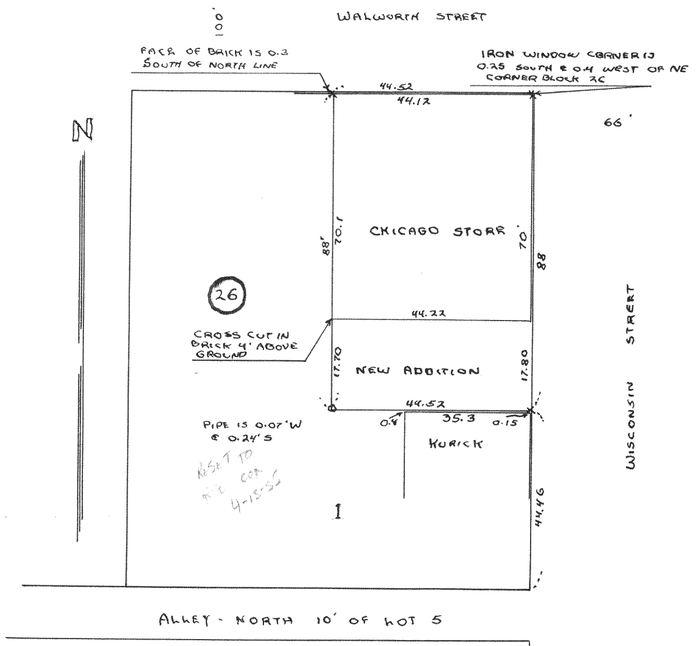

PLAT OF SURVEY OF PART OF EAST 1/2 OF LOT 1, BLOCK 26 OF THE ORIGINAL PLAT OF THE CITY OF ELKHORN WALWORTH COUNTY WISCONSIN
FEBRUARY 1955
LLOYD L JENSEN
SURVEYOR

NORTH LINE OF LOT 1 D.A. REIDS ADD. TO REID'S PARK EXTENDED

#3123

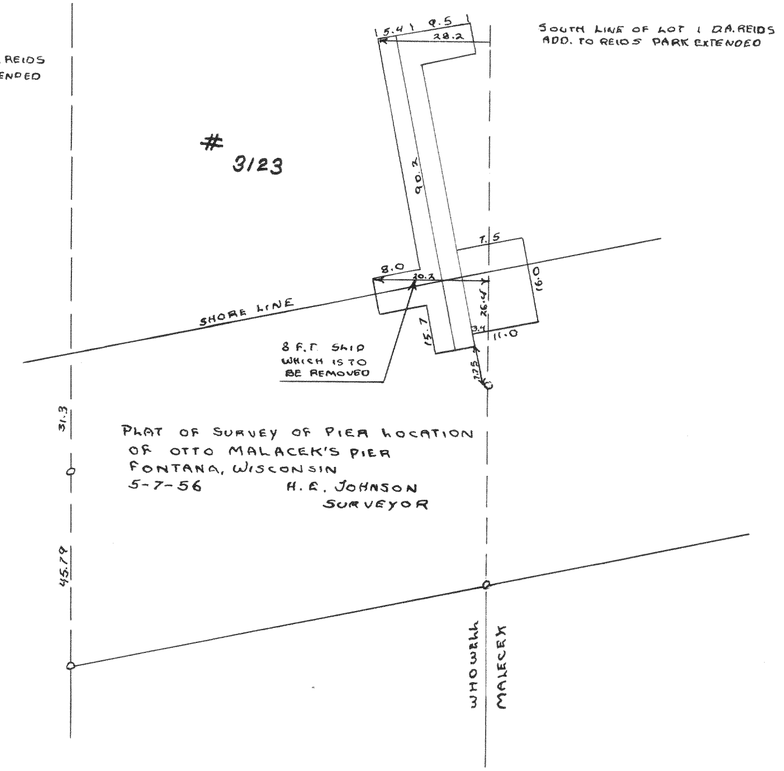

PLAT OF SURVEY OF PIER LOCATION OF OTTO MALACEK'S PIER FONTANA, WISCONSIN
5-7-56
H. E. JOHNSON
SURVEYOR