
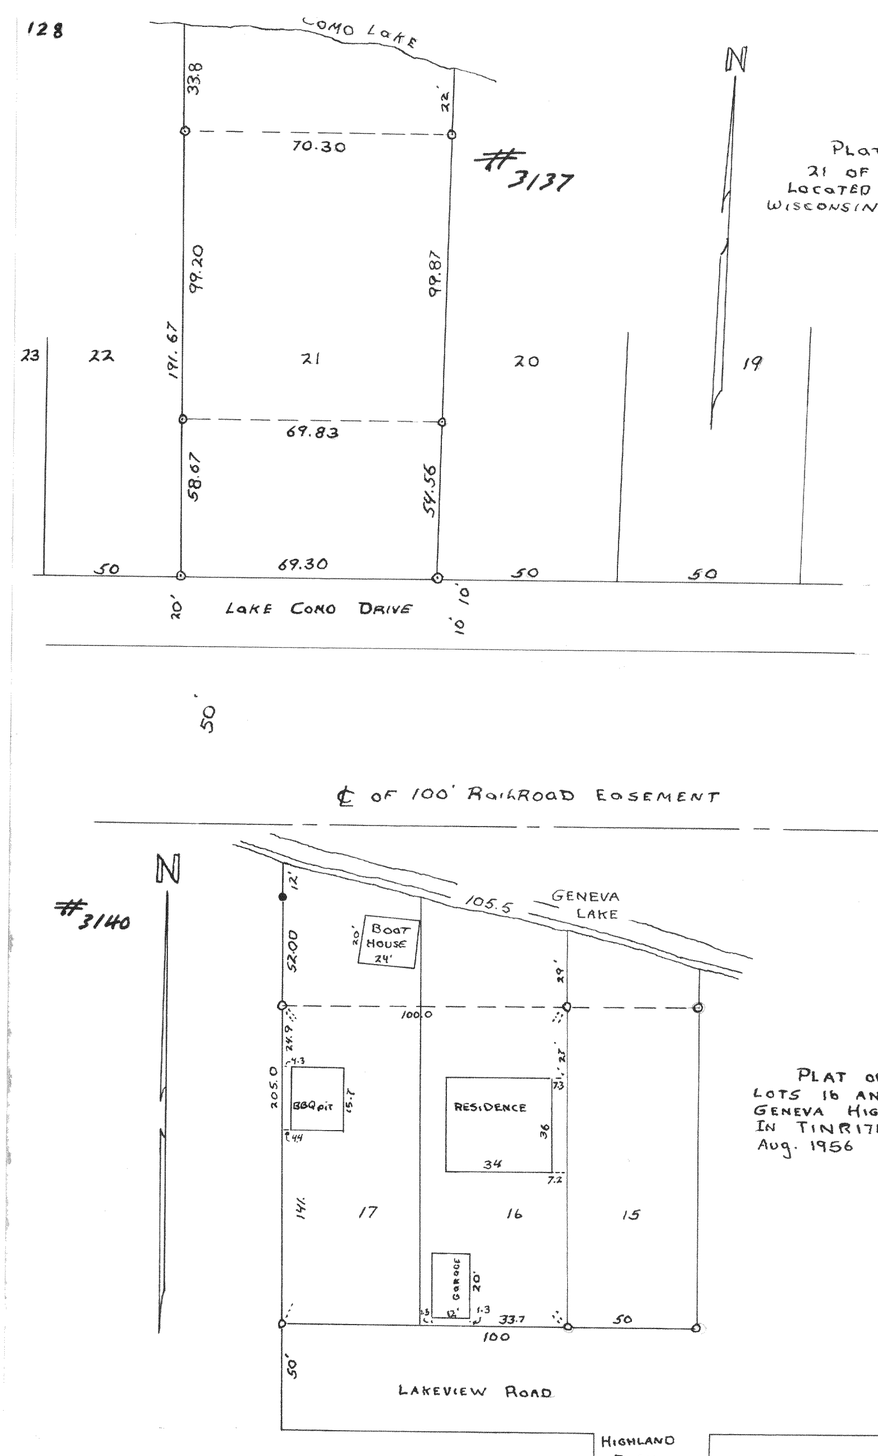


PLAT OF SURVEY OF LOT
21 OF COMSUMERS COMPANY SUB.
LOCATED IN T1N, R17E WALWORTH COUNTY
WISCONSIN, AUGUST 1956 LLOYD L JENSEN
SURVEYOR

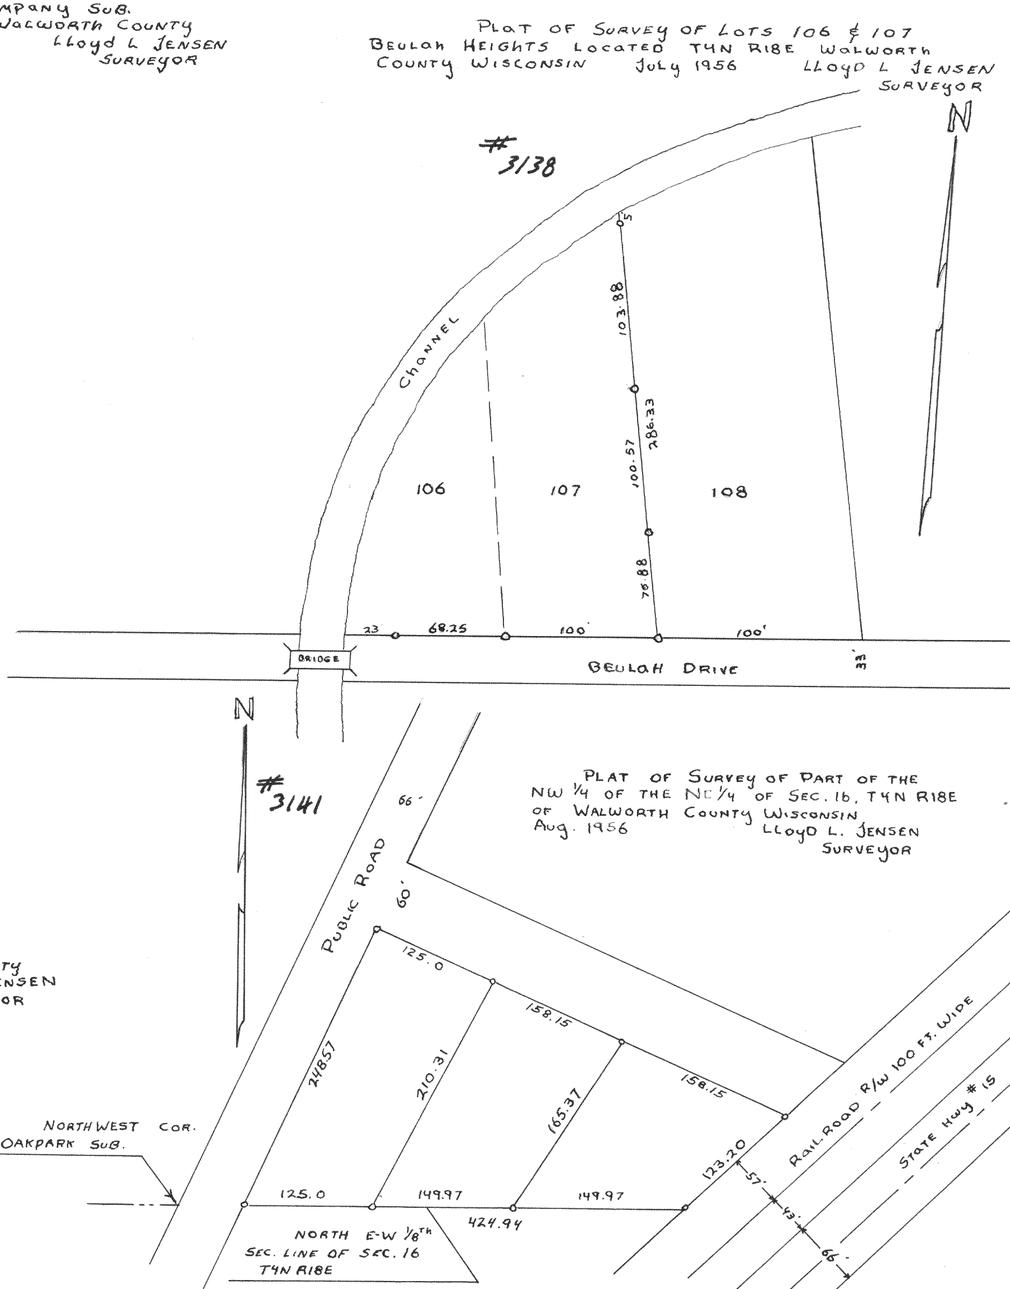

PLAT OF SURVEY OF LOTS 106 & 107
BEULAH HEIGHTS LOCATED T4N R18E WALWORTH
COUNTY WISCONSIN JULY 1956 LLOYD L JENSEN
SURVEYOR

PLAT OF SURVEY OF
LOTS 16 AND 17 OF LAKE
GENEVA HIGHLANDS LOCATED
IN T1N R17E WALWORTH COUNTY
AUG. 1956 LLOYD L. JENSEN
SURVEYOR

PLAT OF SURVEY OF PART OF THE
NW 1/4 OF THE NE 1/4 OF SEC. 16, T4N R18E
OF WALWORTH COUNTY WISCONSIN
AUG. 1956 LLOYD L. JENSEN
SURVEYOR