


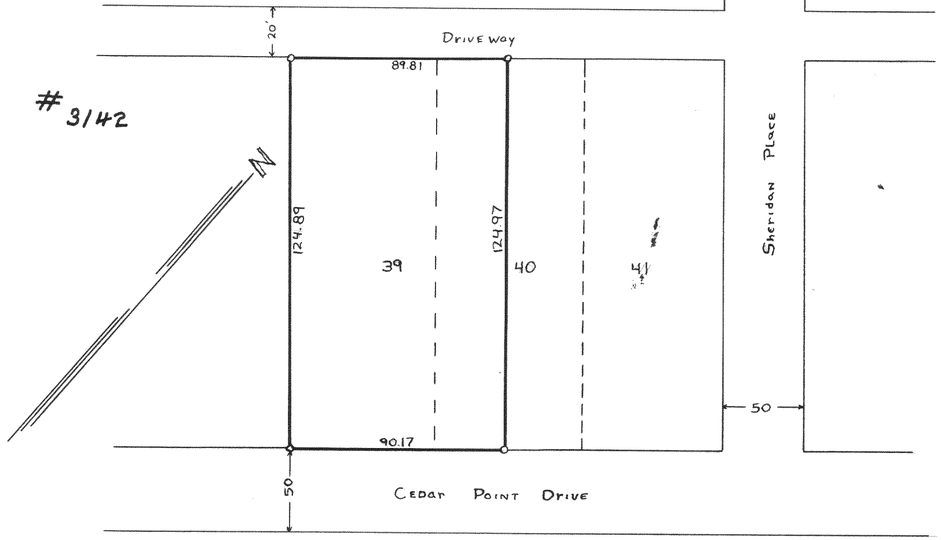


Plat of Survey of Lot 39 and W½ Lot 40 of Original Plat of Cedar Point Park Village of Williams Bay Walworth County Wisconsin
Sept. 1956
Lloyd L. Jensen
Surveyor

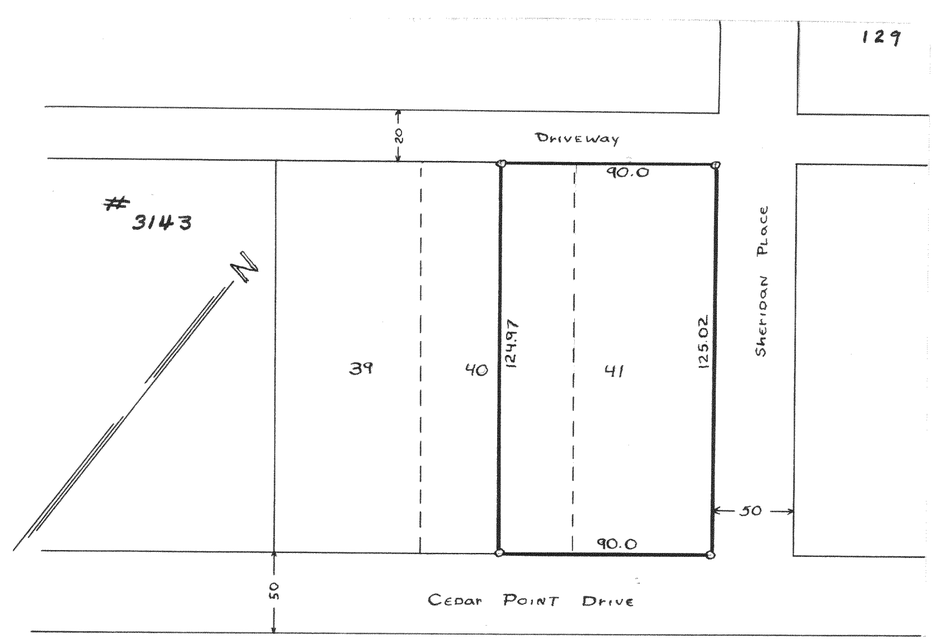

Plat of Survey of Lot 41 and E½ Lot 40 of Original Plat of Cedar Point Park Village of Williams Bay Walworth County Wisconsin
Sept. 1956
Lloyd L. Jensen
Surveyor

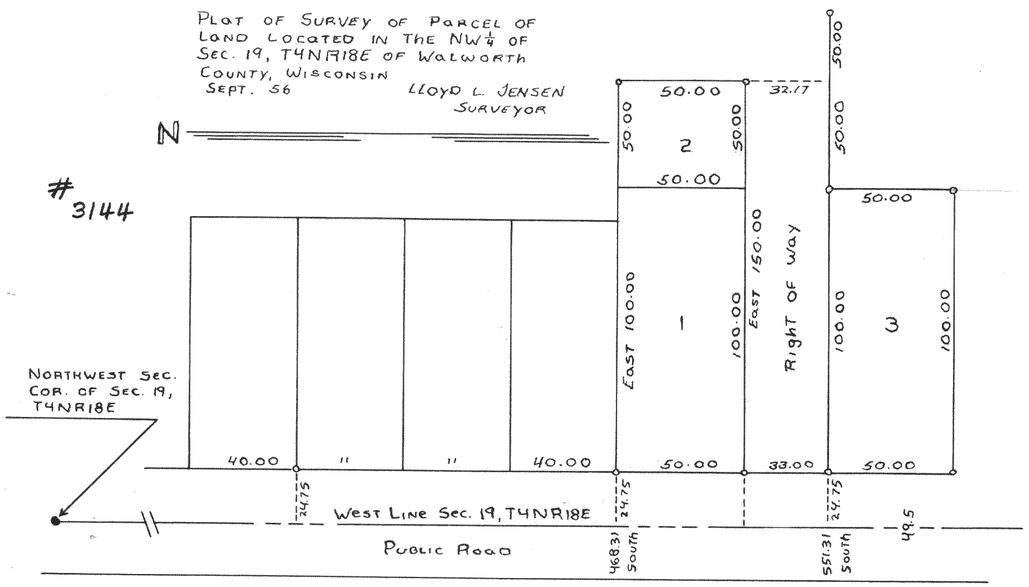

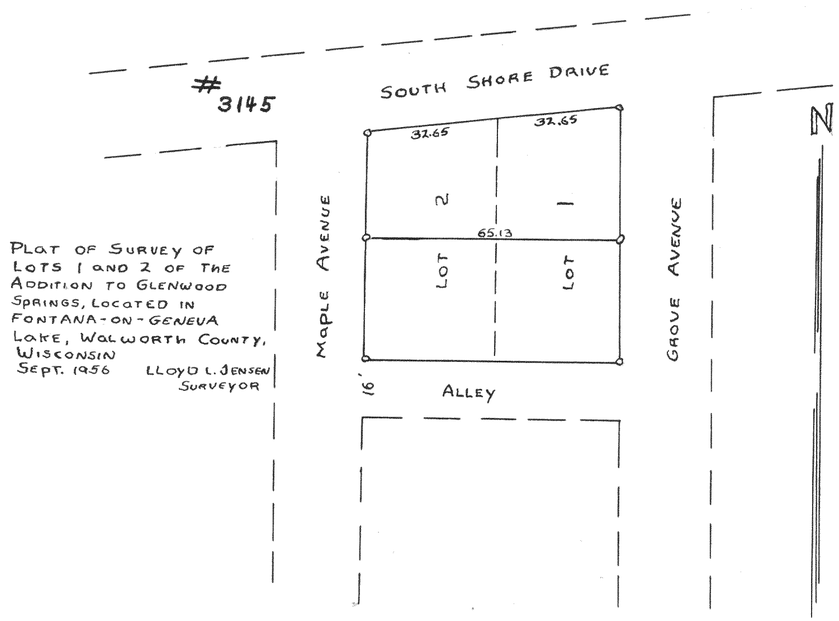

Plat of Survey of Lots 1 and 2 of the Addition to Glenwood Springs, located in Fontana-on-Geneva Lake, Walworth County, Wisconsin
Sept. 1956
Lloyd L. Jensen
Surveyor