

#3159

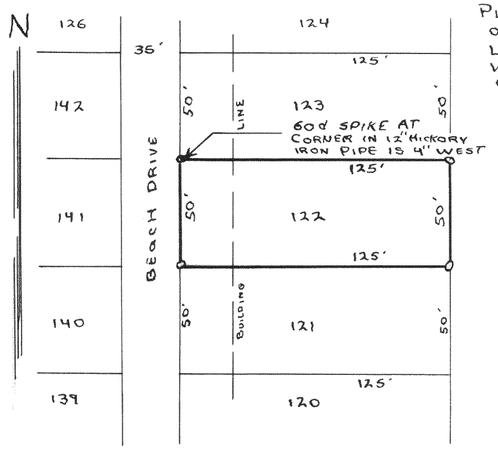


Plat of Survey of Lot 122
of Lake Geneva Beach
Located in T1N R17E of
Walworth County, Wisconsin
Oct 1956 Lloyd L Jensen
Surveyor

#3160

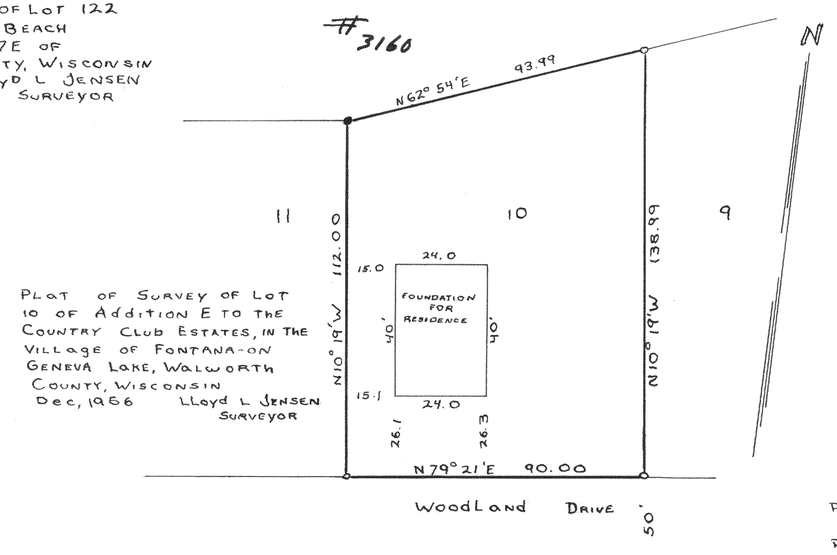


Plat of Survey of Lot
10 of Addition E to the
Country Club Estates, in the
Village of Fontana-on
Geneva Lake, Walworth
County, Wisconsin
Dec, 1956 Lloyd L Jensen
Surveyor

#3161

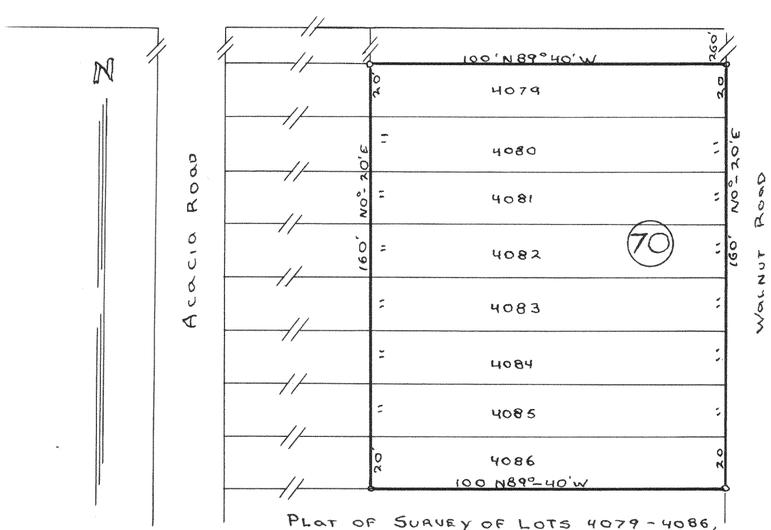

Plat of Survey of Lots 4079-4086,
Block 70, Lake Como Beach Sub.
T2N, R17E Geneva Twp, Walworth
County, Wisconsin
Dec. 1956 Lloyd L Jensen
Surveyor

#3162

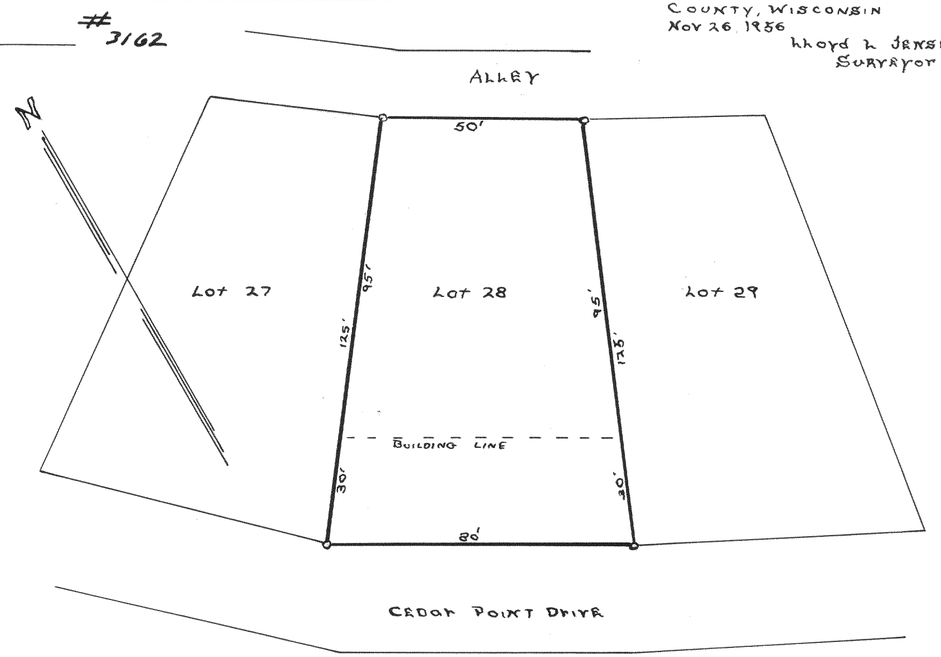

Plat of Survey of Lot 28
of Original Plat of Cedar
Point Park Located in Village
of Williams Bay Walworth
County, Wisconsin
Nov 26 1956
Lloyd L Jensen
Surveyor