



PLAT OF SURVEY OF LOT 20, BLOCK 7 OF WILLIAMS THIRD ADDITION, LYING IN SECTION 1, T1N, R16E, AND SECTION 6, T1N, R17E. ALL BEING IN THE VILLAGE OF WILLIAMS BAY, WALWORTH COUNTY, WISCONSIN
JULY 1956 LLOYD L. JENSEN SURVEYOR

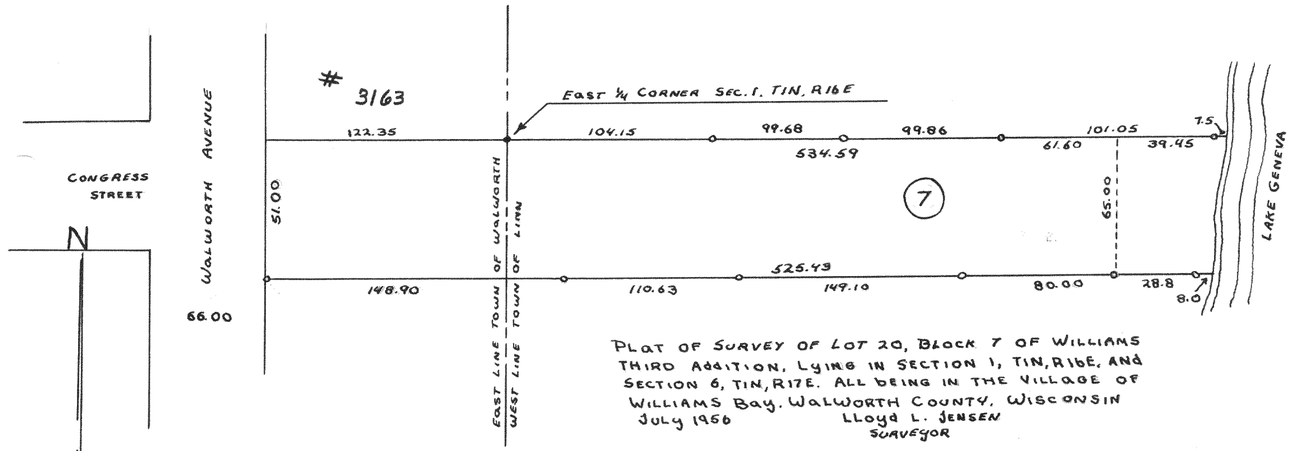

PLAT OF PART OF SECTION 3, T2N R16E, TOWN OF DELAVAN, WALWORTH COUNTY, WISCONSIN
JULY 1956

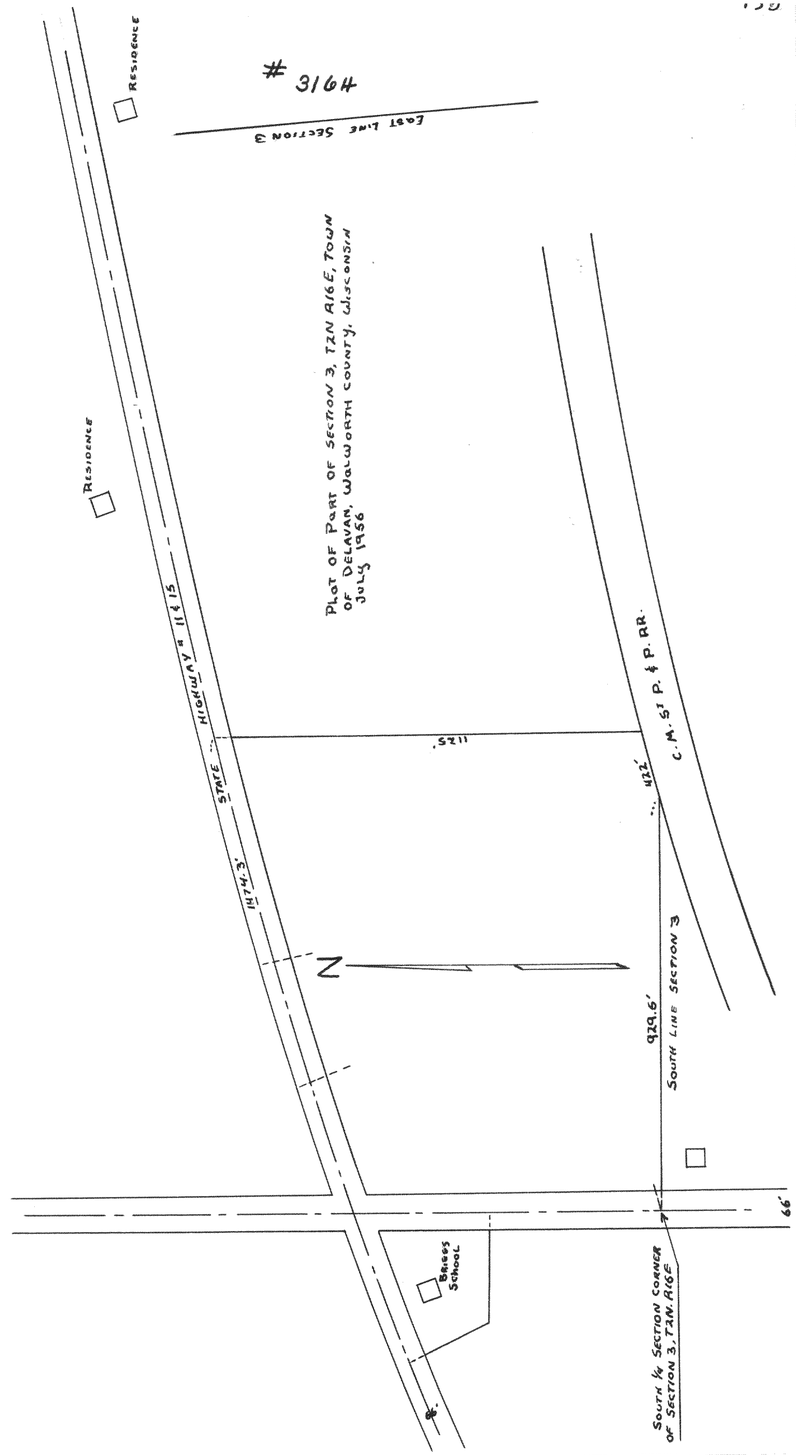