
2662

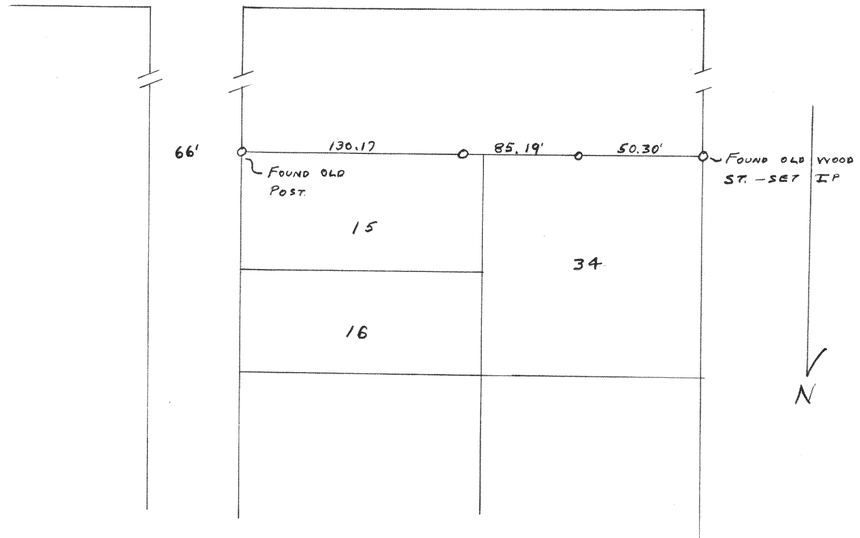


PLAT OF SURVEY OF THE SOUTH LINE OF LOTS 15 AND 34 OF BLOCK 2 OF SIDNEY ALLEN'S ADDITION TO ALLENS GROVE.

OCT 1, 1952

LLOYD L. JENSEN
COUNTY SURVEYOR

2663

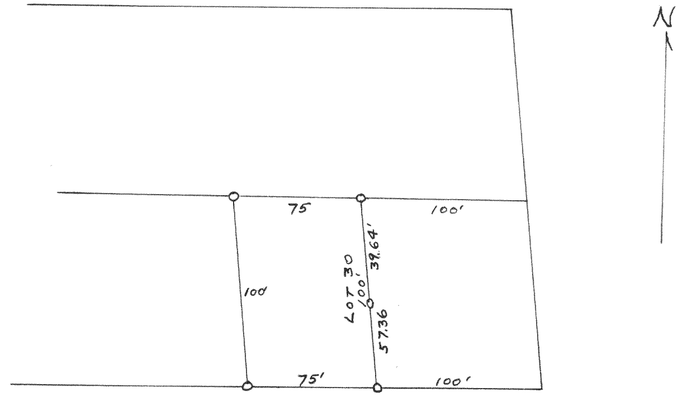

PLAT OF SURVEY OF LOTS 30, 31 & 32 OF BLOCK 107 OF LAKE WANDAWEGA SUBDIVISION, T 3N, R 16E.

1952

LLOYD L. JENSEN
COUNTY SURVEYOR