

#3187

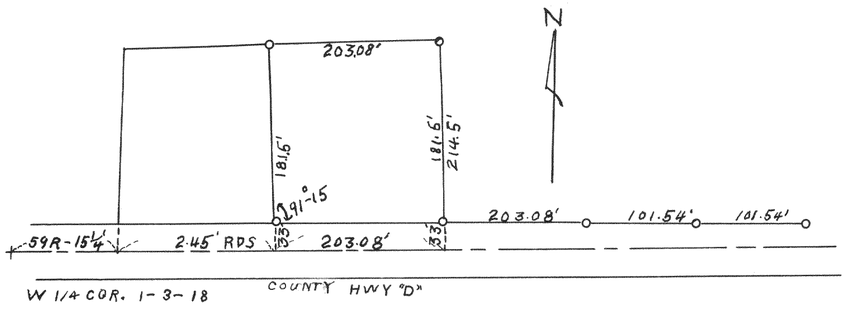

PLAT OF SURVEY OF LAND IN
NW 1/6 SECTION 1 T3N R18E
WALWORTH COUNTY WISCONSIN
NOV. 1956 LLOYD L. JENSEN
SURVEYOR


#3188

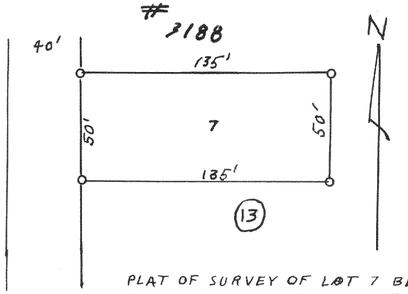


PLAT OF SURVEY OF LOT 7 BLOCK 13
OF MERAMAR T4N R18E
WALWORTH COUNTY WISCONSIN
MAR. 1956 LLOYD L. JENSNE
SURVEYOR

#3189

PLAT OF SURVEY OF LAND IN
NE 1/4 SECTION 3, T4N R18E
WALWORTH COUNTY WISCONSIN
JULY 1956 LLOYD L. JENSEN
SURVEYOR

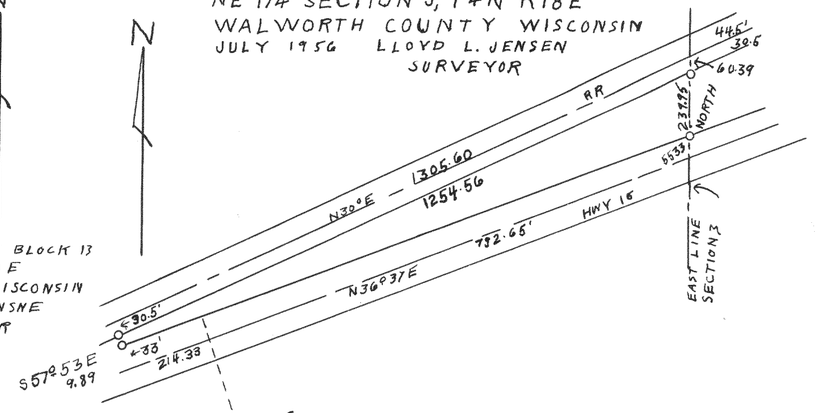


#3190

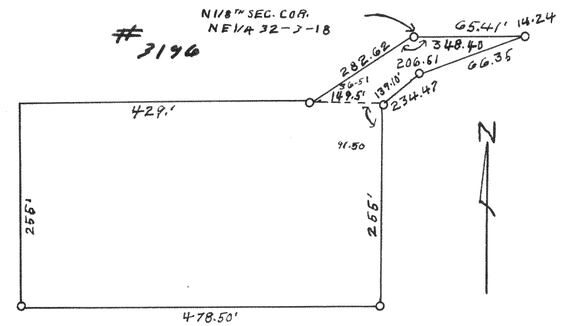


PLAT OF SURVEY OF LAND IN
NE 1/4 SECTION 32 T3N R18E
WALWORTH COUNTY WISCONSIN
MAR 1955 LLOYD L. JENSEN
SURVEYOR

#3191

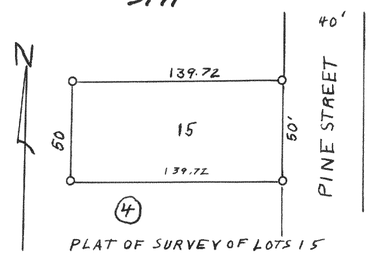


PLAT OF SURVEY OF LOTS 15
BLOCK 4 MIRAMAR T4NR18E
WALWORTH COUNTY WISCONSIN
JUNE 1955 LLOYD L. JENSEN
SURVEYOR

#3192

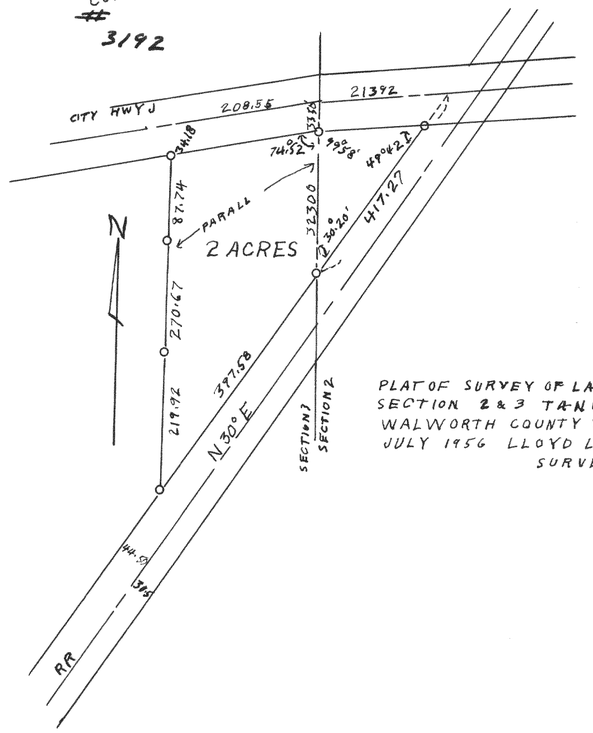


PLAT OF SURVEY OF LAND IN
SECTION 2 & 3 T4N R18E
WALWORTH COUNTY WISCONSIN
JULY 1956 LLOYD L. JENSEN
SURVEYOR

#3193

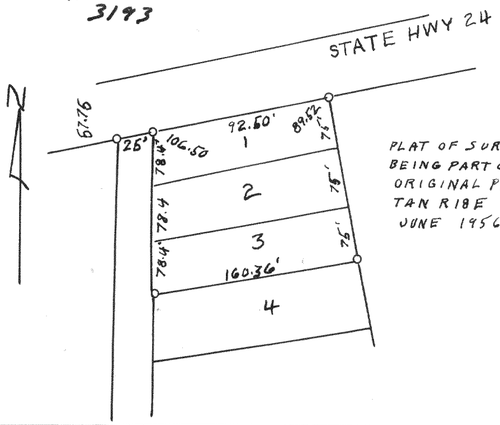

PLAT OF SURVEY OF LOTS 1-3 HUNTERS BLOCK
BEING PART OF LOTS 1-2 OF BLOCK 20 OF
ORIGINAL PLAT OF BEULAH LAKE
T4N R18E WALWORTH COUNTY WISCONSIN
JUNE 1956 LLOYD L. JENSEN
SURVEYOR

#3194

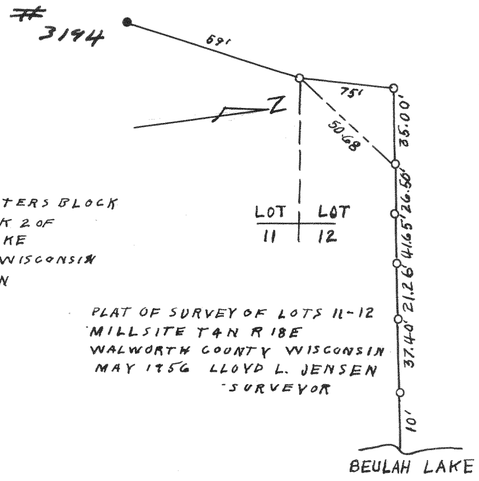

PLAT OF SURVEY OF LOTS 11-12
MILLSITE T4N R18E
WALWORTH COUNTY WISCONSIN
MAY 1956 LLOYD L. JENSEN
SURVEYOR