

#3204

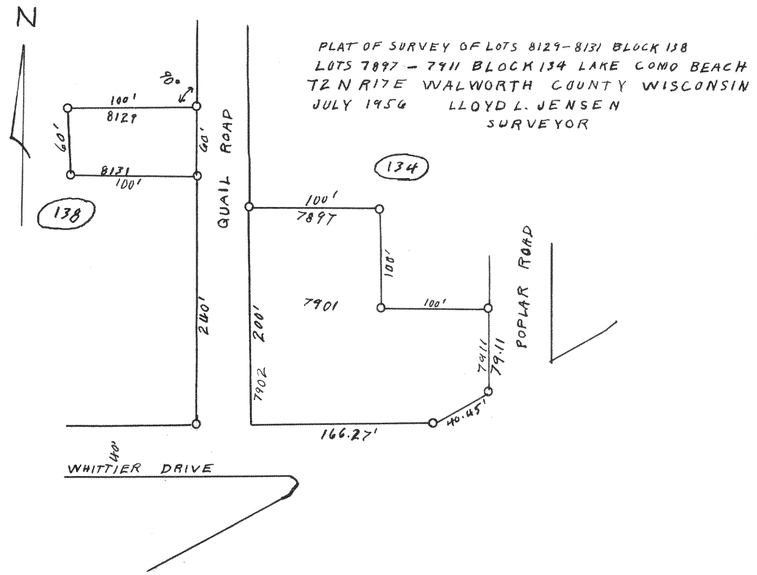


PLAT OF SURVEY OF LOTS 8129-8131 BLOCK 138
LOTS 7897 - 7911 BLOCK 134 LAKE COMO BEACH
T2N R17E WALWORTH COUNTY WISCONSIN
JULY 1956 LLOYD L. JENSEN
SURVEYOR

#3205

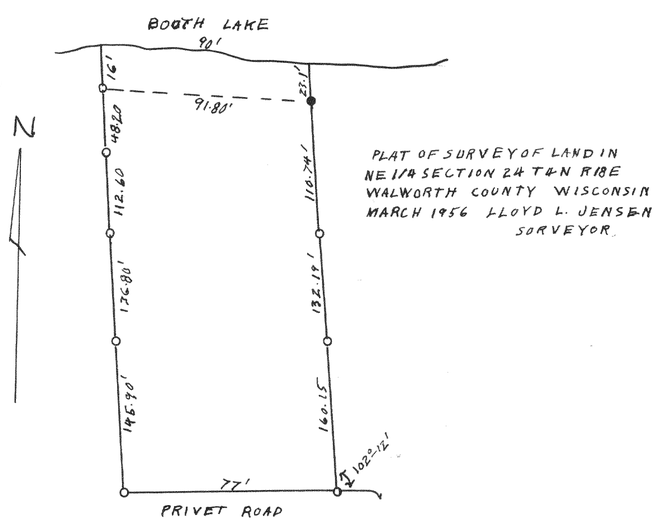


PLAT OF SURVEY OF LAND IN
NE 1/4 SECTION 24 T4N R18E
WALWORTH COUNTY WISCONSIN
MARCH 1956 LLOYD L. JENSEN
SORVEYOR

#3206

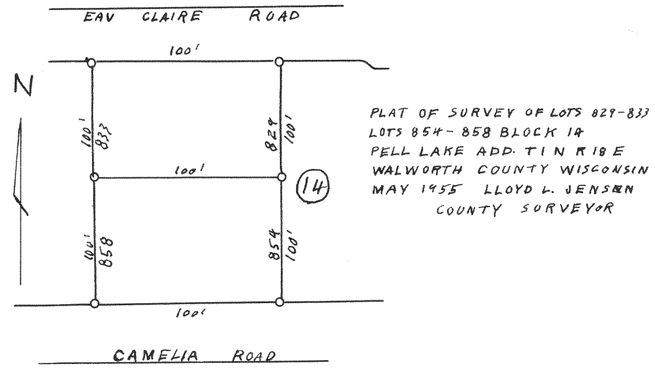


PLAT OF SURVEY OF LOTS 829-833
LOTS 854-858 BLOCK 14
PELL LAKE ADD. T1N R18E
WALWORTH COUNTY WISCONSIN
MAY 1955 LLOYD L. JENSEN
COUNTY SURVEYOR

#3207

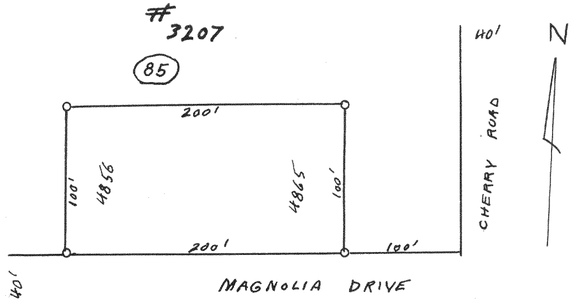


PLAT OF SURVEY OF LOTS 4856-4865 BLOCK 85
LAKE COMO BEACH T2N R17E
WALWORTH COUNTY WISCONSIN
FEB. 1957 LLOYD L JENSEN
SURVEYOR

#3208

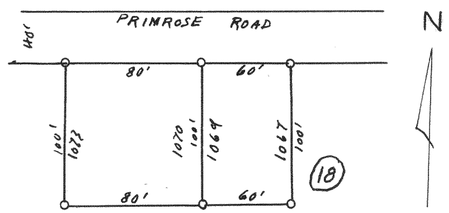


PLAT OF SURVEY OF LOTS 1067-1072 BLOCK 18
PELL LAKL ADDITION T1N R18E
WALWORTH COUNTY WISCONSIN
MAY 1955 LLOYD L. JENSEN
SURVEYOR

#3209

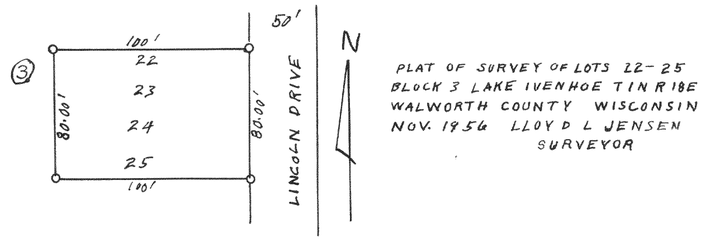

PLAT OF SURVEY OF LOTS 22-25
BLOCK 3 LAKE IVENHOE T1N R18E
WALWORTH COUNTY WISCONSIN
NOV. 1956 LLOYD L JENSEN
SURVEYOR

#3210

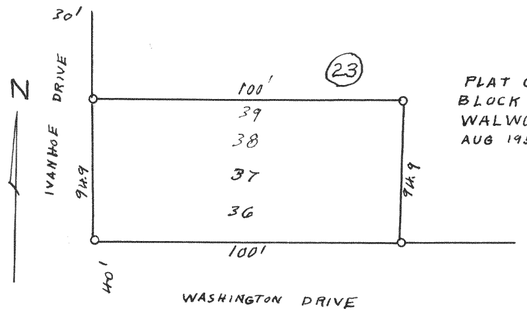

PLAT OF SURVEY OF LOTS 36-39
BLOCK 23 LAKE IVENHOE RESORT
WALWORTH COUNTY WISCONSIN
AUG 1956 LLOYD L. JENSEN
SURVEYOR