

#3221

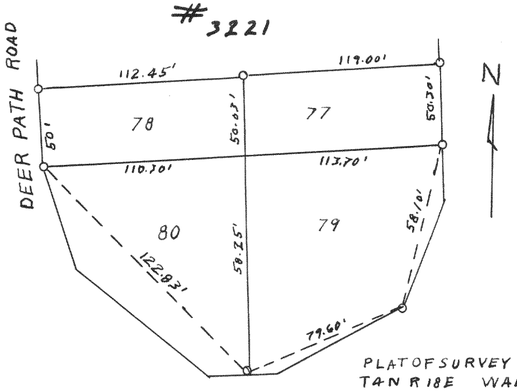


PLAT OF SURVEY OF LOTS 77-80
T4N R18E WALWORTH (O-Tan-Kah)
COUNTY WISCONSIN
APRIL 1956 LLOYD L. JENSEN
SURVEYOR

#3222

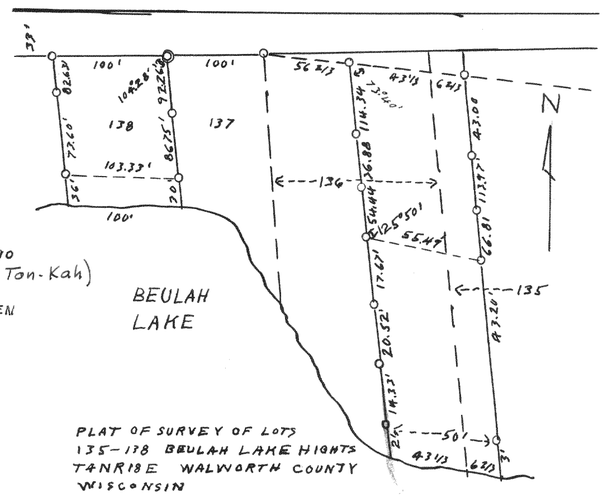


PLAT OF SURVEY OF LOTS
135-138 BEULAH LAKE HIGHTS
T4NR18E WALWORTH COUNTY
WISCONSIN
AUG. 1956 LLOYD L. JENSEN
SURVEYOR

#3223

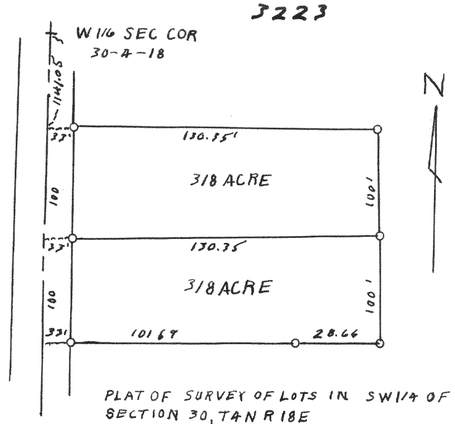


PLAT OF SURVEY OF LOTS IN SW1/4 OF
SECTION 30, T4N R18E
WALWORTH COUNTY WISCONSIN
AUG. 1956 LLOYD L. JENSEN
SURVEYOR

#3224

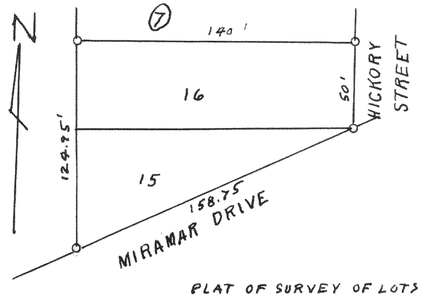


PLAT OF SURVEY OF LOTS
15-16 BLOCK 7 MIRAMAR T4N R18E
WALWORTH COUNTY WISCONSIN
MAY. 1956 LLOYD L. JENSEN
SURVEYOR

#3225

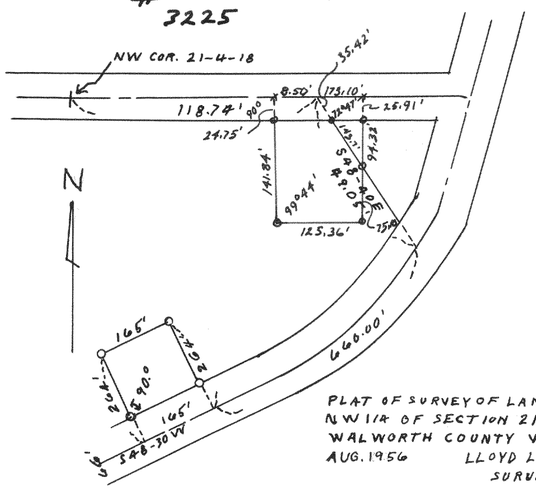


PLAT OF SURVEY OF LAND IN
NW1/4 OF SECTION 21, T4N R18E
WALWORTH COUNTY WISCONSIN
AUG. 1956 LLOYD L. JENSEN
SURVEYOR

#3226

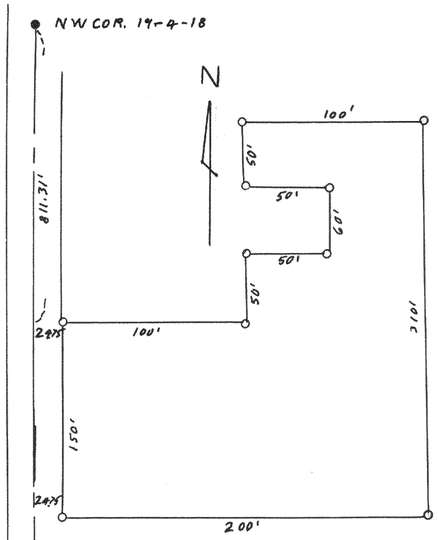

PLAT OF SURVEY OF LAND IN THE NW1/4
SECTION 19 T4N R18E
WALWORTH COUNTY WASCONSIN
JULY 1955 LLOYD L. JENSEN
SURVEYOR

#3227

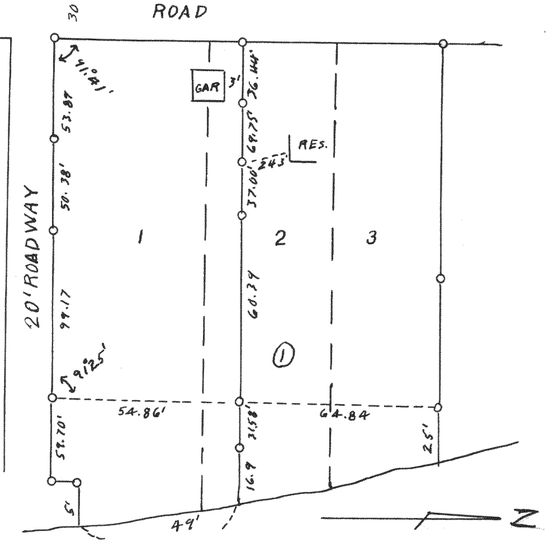

PLAT OF SURVEY OF LOTS 1-3 BLOCK 1
WILMER GROVE BEACH T4N R18E
WALWORTH COUNTY WISCONSIN
SEPT 1956 LLOYD L. JENSEN
SURVEYOR