

#3233

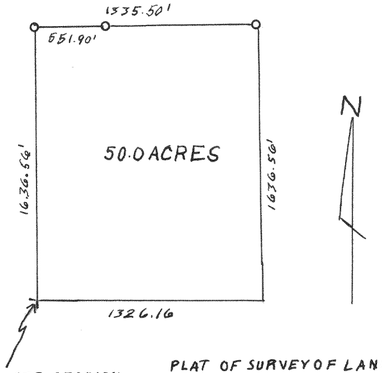

CTR. SECTION
19-1-16


PLAT OF SURVEY OF LAND IN
W1/2 NE1/4 SECTION 19
T1N R15E
WALWORTH COUNTY WISCONSIN
JAN. 1957 LLOYD L. JENSEN
SURVEYOR

#3233

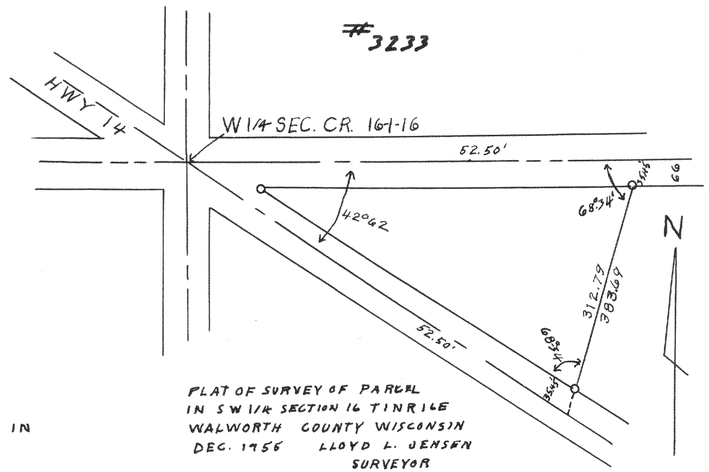


PLAT OF SURVEY OF PARCEL
IN SW1/4 SECTION 16 T1N R16E
WALWORTH COUNTY WISCONSIN
DEC. 1956 LLOYD L. JENSEN
SURVEYOR

#3234

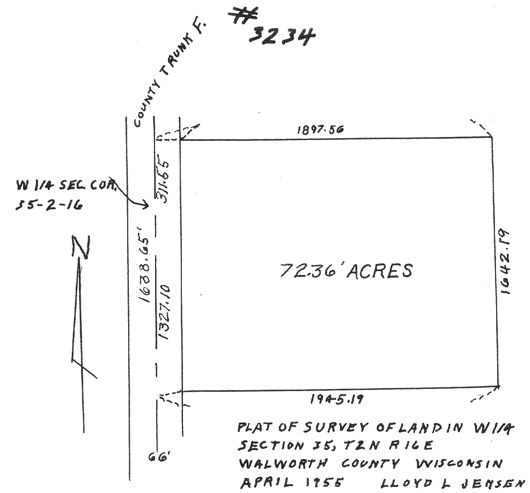


PLAT OF SURVEY OF LAND IN W1/4
SECTION 35, T2N R16E
WALWORTH COUNTY WISCONSIN
APRIL 1956 LLOYD L JENSEN
SURVEYOR


#3235

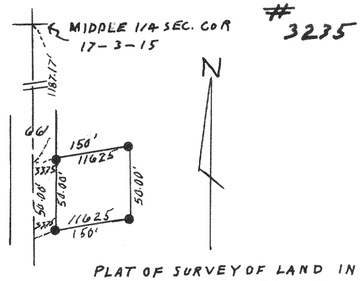

PLAT OF SURVEY OF LAND IN
NW1/4 SE.1/4 SECTION 17
T3N R15E WALWORTH COUNTY
WISCONSIN
DEC. 1966 LLOYD L. JENSEN
SURVEYOR


#3236

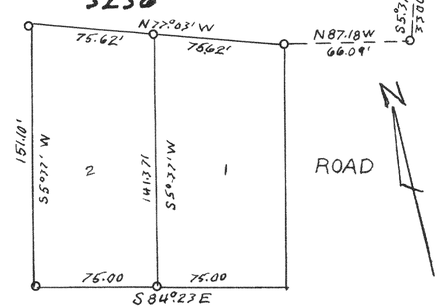

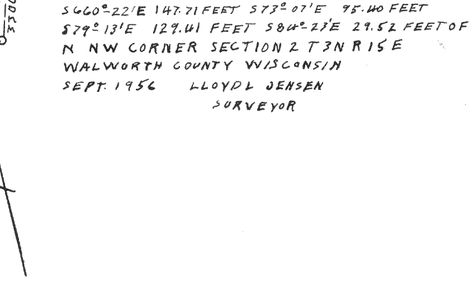

POINT IS EAST 161.90' S 60°-21'E 129.74 FEET
S 660°-22'E 147.71 FEET S 73° 07'E 95.40 FEET
S 79°-13'E 129.41 FEET S 84°-23'E 29.52 FEET OF
N NW CORNER SECTION 2 T3N R15E
WALWORTH COUNTY WISCONSIN
SEPT. 1956 LLOYD L JENSEN
SURVEYOR

#3237

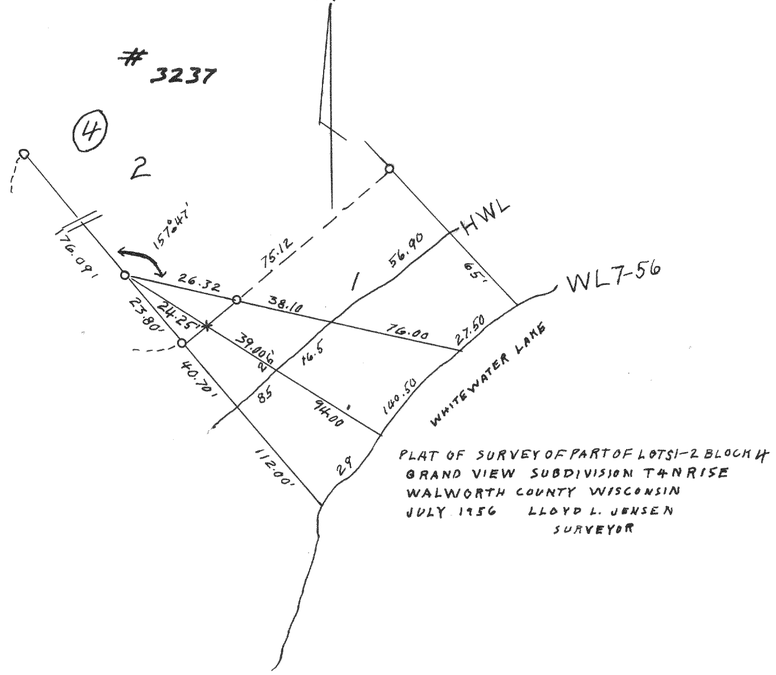

PLAT OF SURVEY OF PART OF LOTS 1-2 BLOCK 4
GRAND VIEW SUBDIVISION T4N R15E
WALWORTH COUNTY WISCONSIN
JULY 1956 LLOYD L. JENSEN
SURVEYOR