

#3246

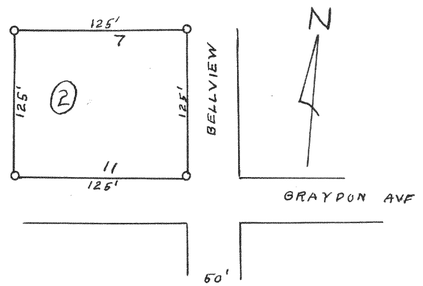


PLAT OF SURVEY OF LOTS 7-11 BLOCK 2 CLARKES ADD.
VILLAGE OF EAST TROY WALWORTH COUNTY WISCONSIN
APR. 1956 LLOYD L. JENSEN
SURVEYOR

#3247

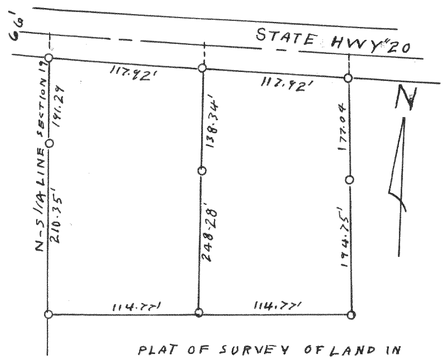


PLAT OF SURVEY OF LAND IN
SECTION 19 VILLAGE OF EAST TROY
WALWORTH COUNTY WISCONSIN
MARCH 1957 LLOYD L. JENSEN
SURVEYOR

#3248

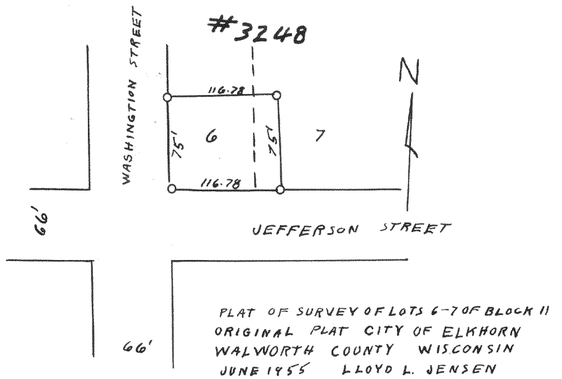

PLAT OF SURVEY OF LOTS 6-7 OF BLOCK 11
ORIGINAL PLAT CITY OF ELKHORN
WALWORTH COUNTY WISCONSIN
JUNE 1955 LLOYD L. JENSEN
SURVEYOR

#3249

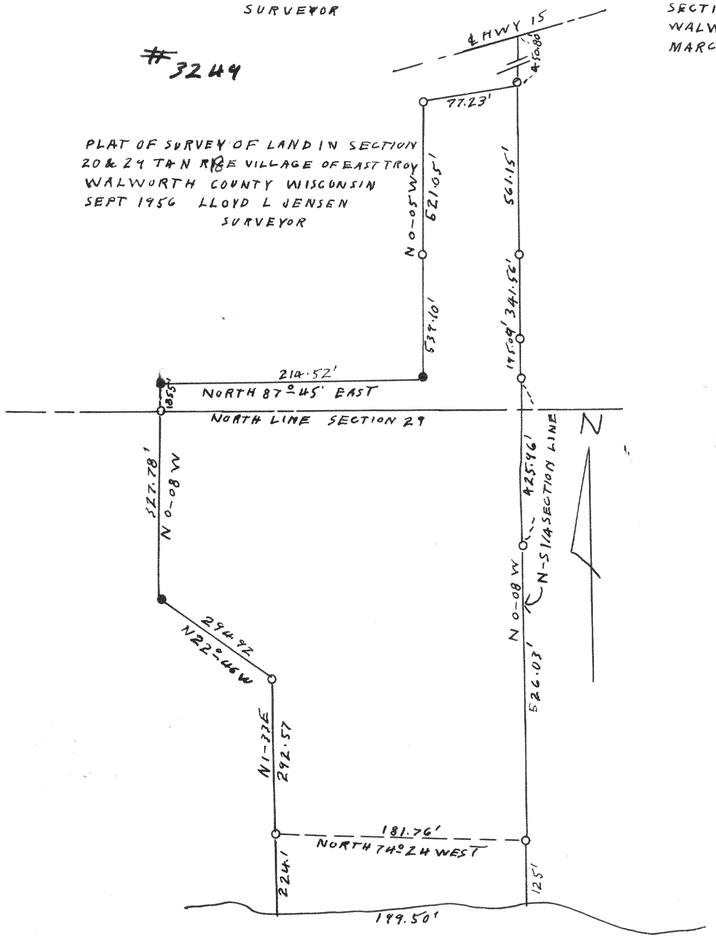


PLAT OF SURVEY OF LAND IN SECTION
20 & 29 T4N R18E VILLAGE OF EAST TROY
WALWORTH COUNTY WISCONSIN
SEPT 1956 LLOYD L JENSEN
SURVEYOR

#3250

PLAT OF SURVEY OF LAND IN
E 1/2 SECTION 6 T2N R17E
CITY OF ELKHORN
WALWORTH COUNTY WISCONSIN
MARCH 1955 LLOYD L. JENSEN
SURVEYOR

#3251

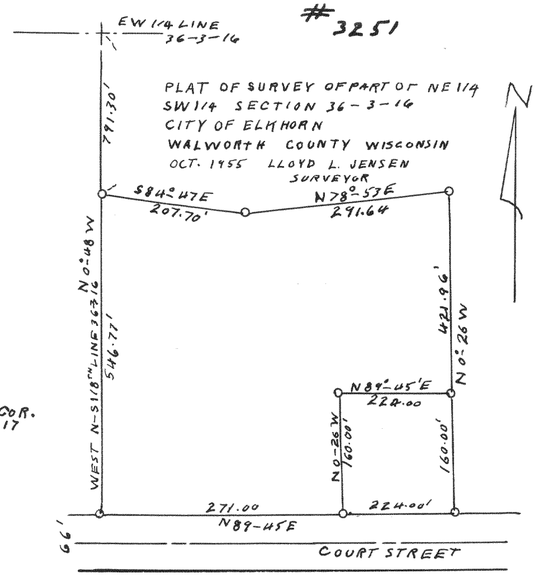

PLAT OF SURVEY OF PART OF NE 1/4
SW 1/4 SECTION 36-3-16
CITY OF ELKHORN
WALWORTH COUNTY WISCONSIN
OCT. 1955 LLOYD L. JENSEN
SURVEYOR