

#3252

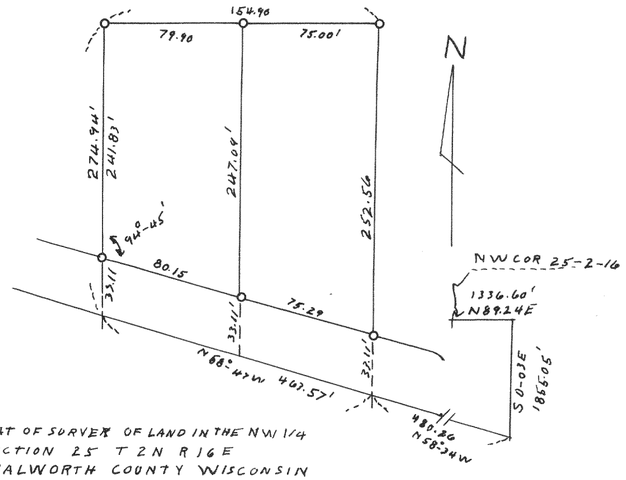


PLAT OF SURVEY OF LAND IN THE NW 1/4
SECTION 25 T 2N R 16E
WALWORTH COUNTY WISCONSIN
JULY 1955 LLOYD L. JENSEN
SURVEYOR

#3253

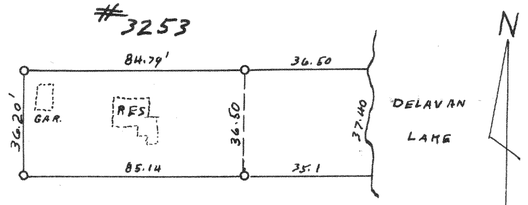


PLAT OF SURVEY OF LOT 1 DUNCANSONS
LAKE SHORE ADD. T2N R16E
WALWORTH COUNTY WISCONSIN
OCT. 1955 LLOYD L. JENSEN
SURVEYOR

#3254

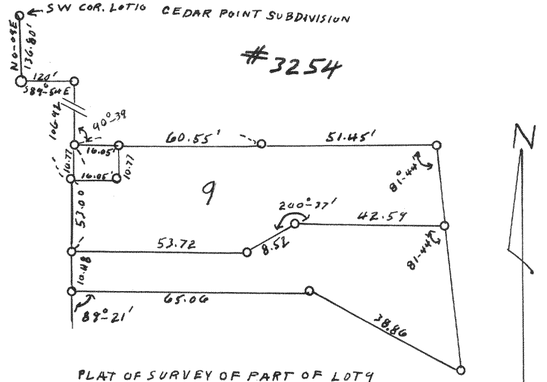


PLAT OF SURVEY OF PART OF LOT 9
CEDAR POINT SUB. T2N R16E
WALWORTH COUNTY WISCONSIN
NOV. 1956 LLOYD L. JENSEN
SURVEYOR

#3255

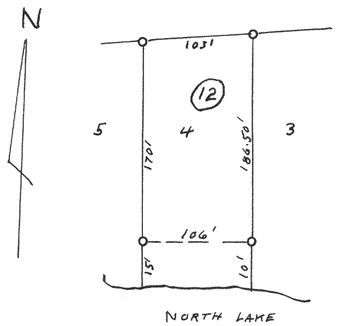


PLAT OF SURVEY OF LOT 4 OF BLOCK
BLUE WING ESTATES T3N R16E
WALWORTH COUNTY WISCONSIN
MAY 1955 LLOYD L JENSEN
SURVEYOR

#3256

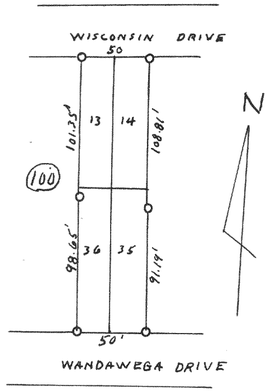


PLAT OF SURVEY OF LOTS 13, 14, 35
AND 36 OF BLOCK 100 LAKE WANDAWEGA
SUBDIVISION T3N R16E
WALWORTH COUNTY WISCONSIN
APRIL 1955 LLOYD L. JENSEN
SURVEYOR

#3257

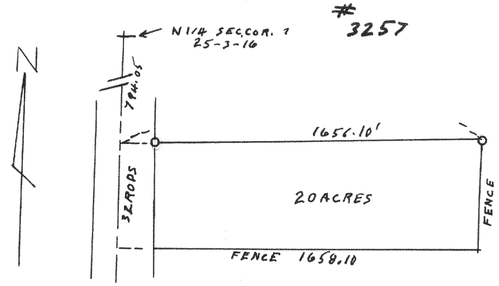

PLAT OF SURVEY OF LAND IN THE NW 1/6 NE 1/4
SECTION 25 T3N R16E WALWORTH
COUNTY WISCONSIN MAY 1956
LLOYD L. JENSEN SURVEYOR

#3258

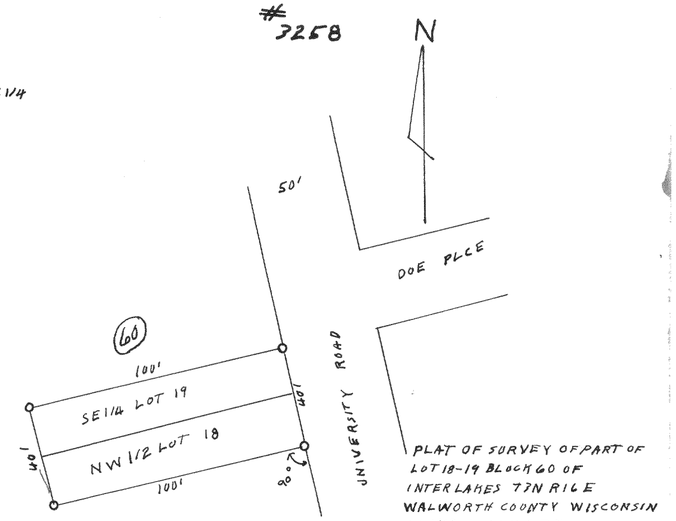

PLAT OF SURVEY OF PART OF
LOT 18-19 BLOCK 60 OF
INTERLAKES T3N R16E
WALWORTH COUNTY WISCONSIN
LLOYD L JENSEN
SURVEYOR 1956