

#3266

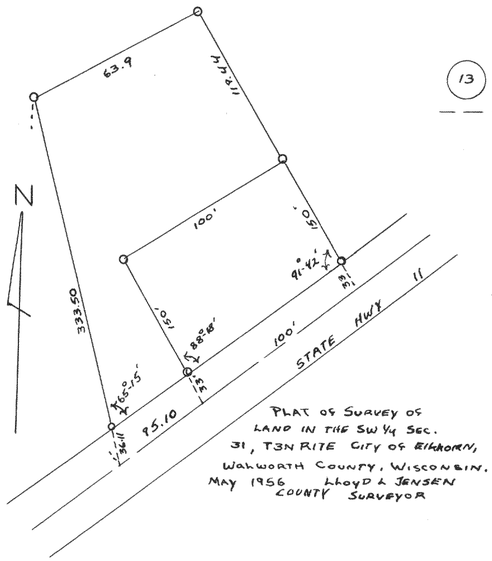


PLAT OF SURVEY OF
LAND IN THE SW¼ SEC.
31, T3N R17E CITY OF ELKHORN,
WALWORTH COUNTY, WISCONSIN.
MAY 1956 LLOYD L JENSEN
COUNTY SURVEYOR

#3267

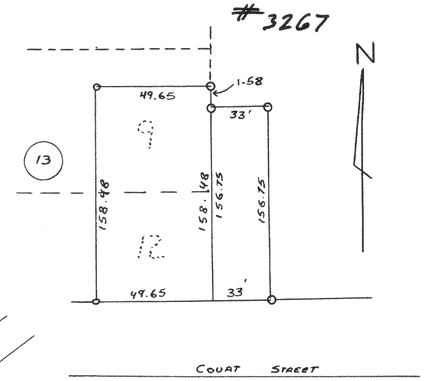


PLAT OF SURVEY OF PART OF LOTS 9 & 12 OF BLOCK
13 OF ROCKWELLS ADDITION ALSO PARCEL TO EAST
CITY OF ELKHORN WALWORTH COUNTY WISCONSIN
SEPT. 1956 LLOYD L. JENSEN
SURVEYOR

#3268

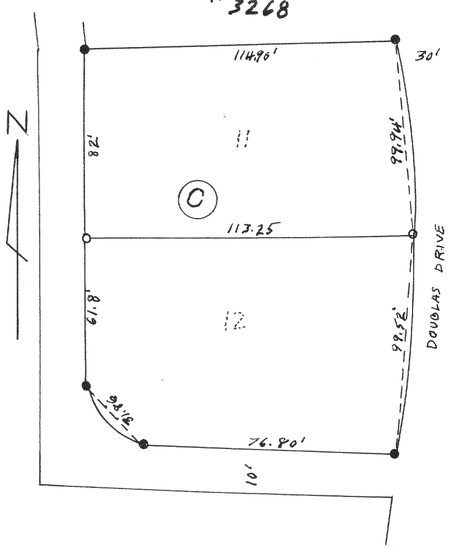


PLAT OF SURVEY OF LOTS 10-11
BLACK "C" UNIT 3 COUNTRY CLUB ESTATES
VILLAGE OF FONTANA ON GENEVA LAKE
WALWORTH COUNTY WISCONSIN
DEC. 1956 LLOYD L. JENSEN
SURVEYOR

#3269

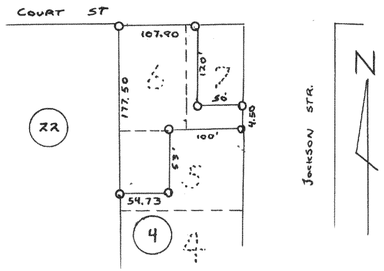


PLAT OF SURVEY OF PART OF LOTS 5-6-7
BLOCK 4 OF ARNOLDS ADD. TO THE
CITY OF ELKHORN, WALWORTH COUNTY WISCONSIN
AUG 1956 LLOYD L JENSEN
COUNTY SURVEYOR

#3270

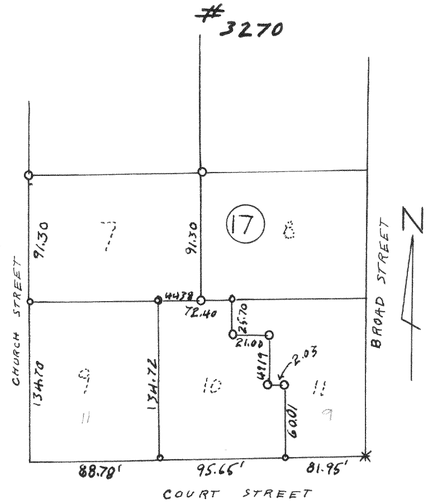


PLAT OF SURVEY OF PART OF LOT 10 BLOCK 17
ORIGINAL TOWN CITY OF ELKHORN
WALWORTH COUNTY WISCONSIN
NOV 1954 LLOYD L. JENSEN
SURVEYOR

#3271

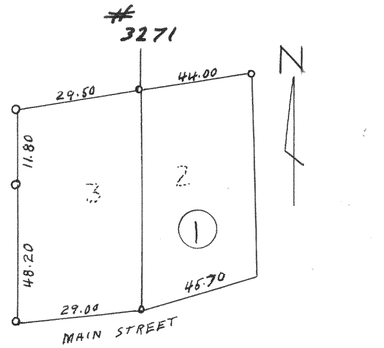

PLAT OF SURVEY OF LOT 1 BLOCK 1
C.L. DOUGLASS ADDITION
VILLAGE OF FONTANA ON GENEVA LAKE
WALWORTH COUNTY WISCONSIN
NOV. 1955 LLOYD L JENSEN
SURVEYOR

#3272

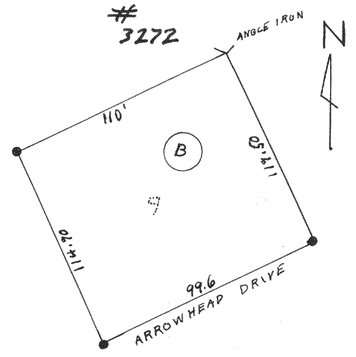

PLAT OF SURVEY OF LOT 9 BLOCK B
UNIT 3 COUNTRY CLUB ESTATES
VILLAGE OF FONTANA ON GENEVA LAKE
WALWORTH COUNTY WISCONSIN
MARCH 1955 LLOYD L JENSEN
SURVEYOR