

#3273

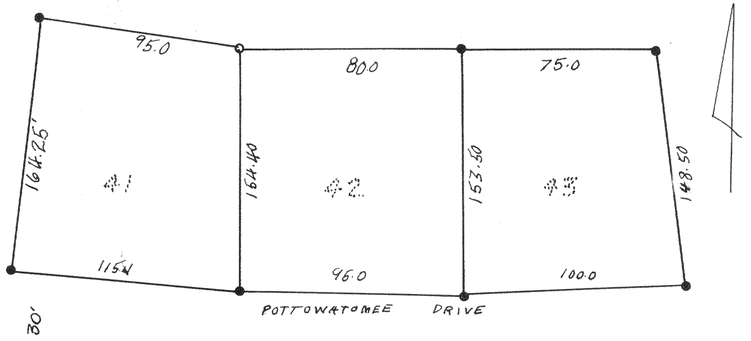


PLAT OF SURVEY OF LOT 1 4 AND 3 UNIT 2
COUNTRY CLUB ESTATES VILLAGE OF
FONTANA ON GENEVA LAKE
WALWORTH COUNTY WISCONSIN
JULY 1956 LLOYD L JENSEN
SURVEYOR

#3274

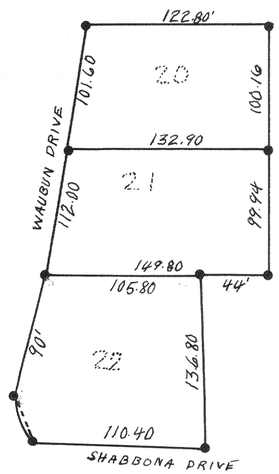


PLAT OF SURVEY OF LOTS 20-22
UNIT 2 COUNTRY CLUB ESTATES
VILLAGE OF FONTANA ON GENEVA LAKE
WALWORTH COUNTY WISCONSIN
APRIL 1956 LLOYD L. JENSEN
SURVEYOR

#3275

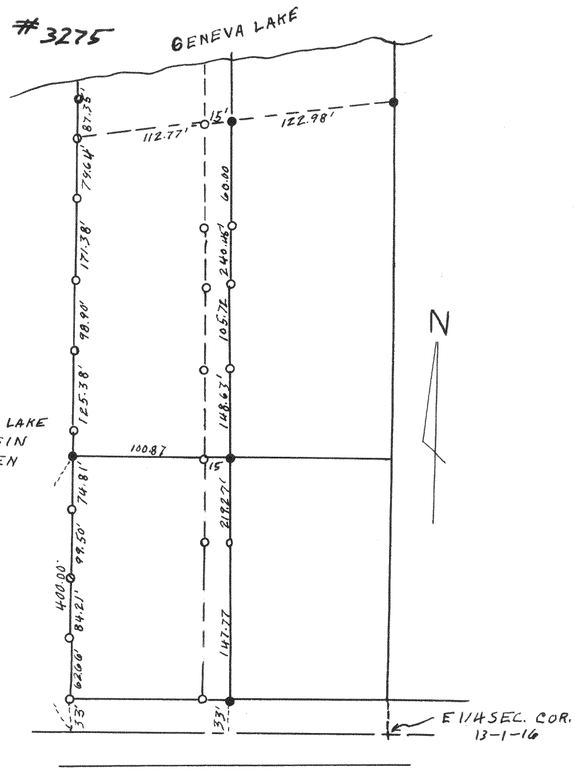


PLAT OF SURVEY OF LAND IN SECTION 13
T 1 N R 16 E WALWORTH COUNTY WISCONSIN
FEB 1957 LLOYD L. JENSEN
SURVEYOR

#3276

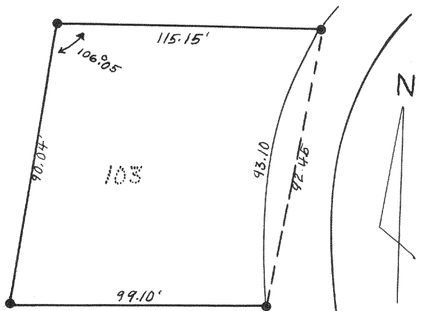


PLAT OF SURVEY OF LOT 103 UNIT 2
COUNTRY CLUB ESTATES VILLAGE OF
FONTANA ON GENEVA LAKE
WALWORTH COUNTY WISCONSIN
JULY 1956 LLOYD L. JENSEN
SURVEYOR

#3277

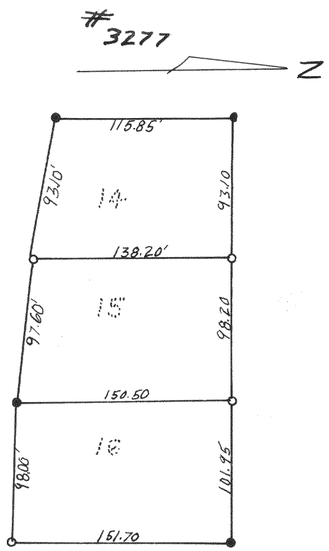

PLAT OF SURVEY OF LOT 14-16 UNIT 2
COUNTRY CLUB ESTATES VILLAGE OF
FONTANA ON GENEVA LAKE
WALWORTH COUNTY WISCONSIN
APRIL 1956 LLOYD L JENSEN
SURVEYOR

#3278

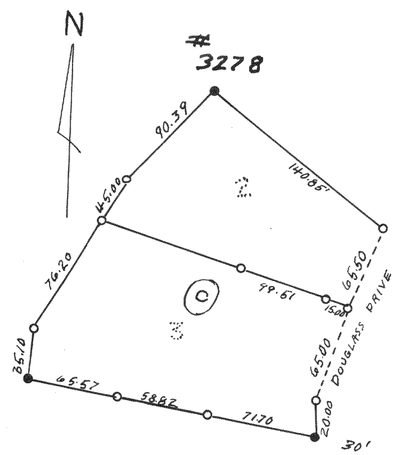

PLAT OF SURVEY OF LOT 2 & 3 BLOCK C
UNIT 3 COUNTRY CLUB ESTATES
VILLAGE OF FONTANA ON GENEA LAKE
WALWORTH COUNTY WISCONSIN
ARRIL 1956 LLOYD L JENSEN
SURVEYOR