

2668

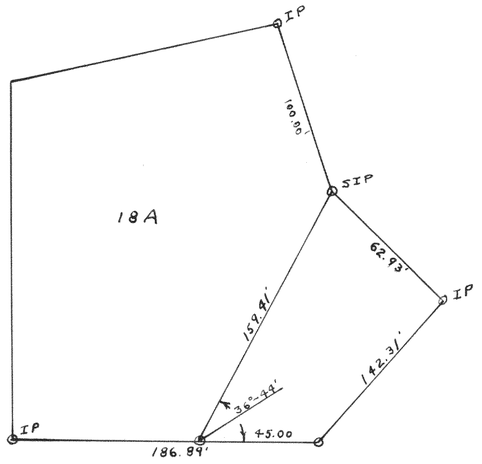

PLAT OF SURVEY OF PART OF LOT 18A OF TRINKE ESTATES, LOCATED IN SECTION 10, T1N R17E.
JUNE 17, 1952

Lloyd L Jensen SA
COUNTY SURVEYOR

2669

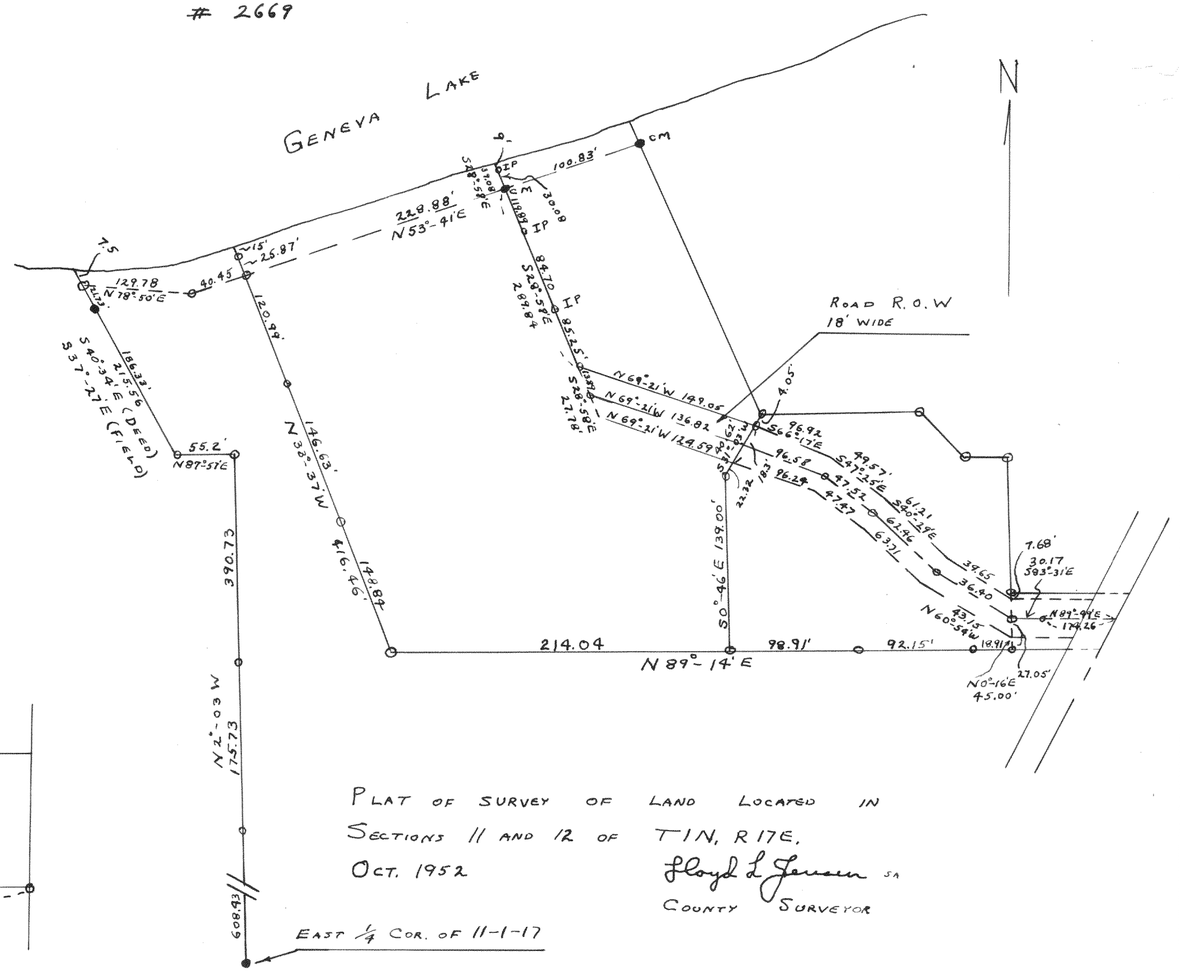


PLAT OF SURVEY OF LAND LOCATED IN SECTIONS 11 AND 12 OF T1N, R17E.
OCT. 1952

Lloyd L Jensen SA
COUNTY SURVEYOR

EAST 1/4 COR. OF 11-1-17

2670

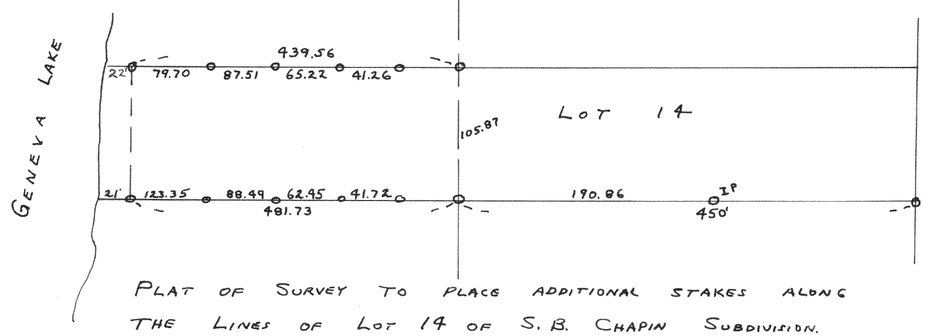

PLAT OF SURVEY TO PLACE ADDITIONAL STAKES ALONG THE LINES OF LOT 14 OF S. B. CHAPIN SUBDIVISION.
AUGUST 1952

Lloyd L Jensen SA
COUNTY SURVEYOR