3305

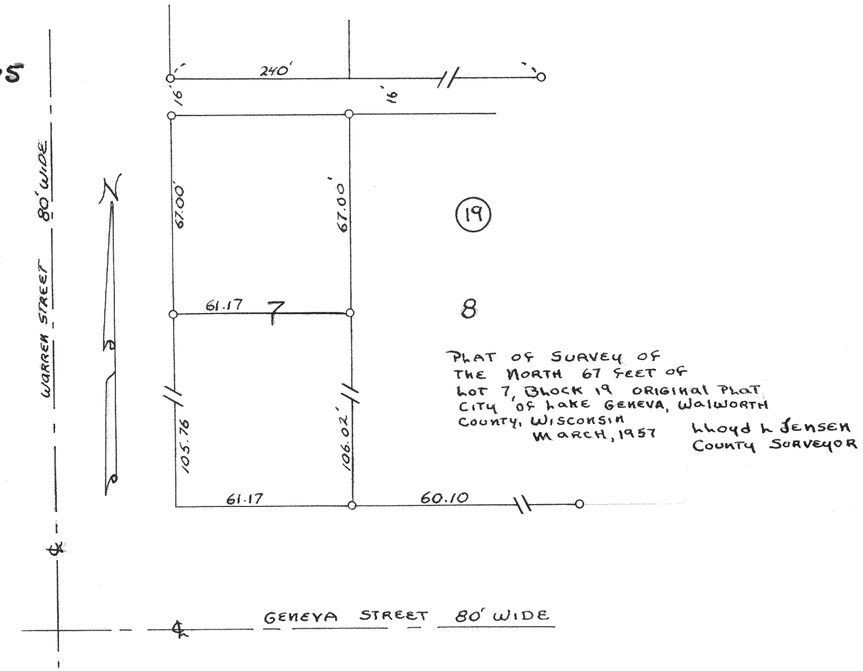

Plat of Survey of
The North 67 feet of
Lot 7, Block 19 Original Plat
City of Lake Geneva, Walworth
County, Wisconsin
March, 1957

Lloyd H. Jensen
County Surveyor

3306

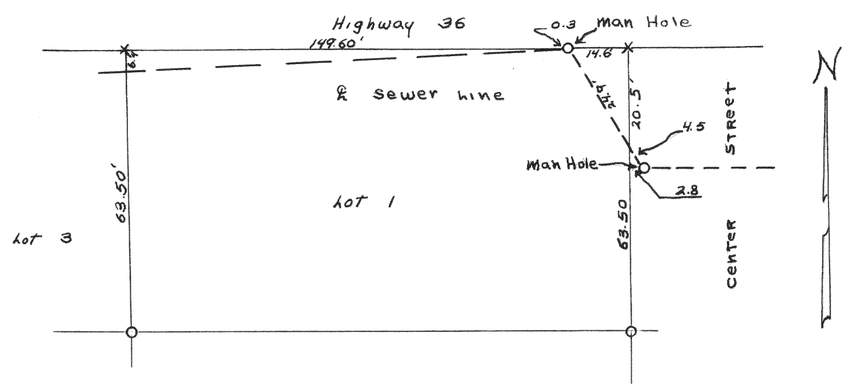

O - Iron Pipe
X - Cross cut in Concrete

Plat of Survey of Lot 1,
Warhurst's Subdivision, City
of Lake Geneva, Walworth
County, Wisconsin
June 1957

Lloyd H. Jensen
County Surveyor
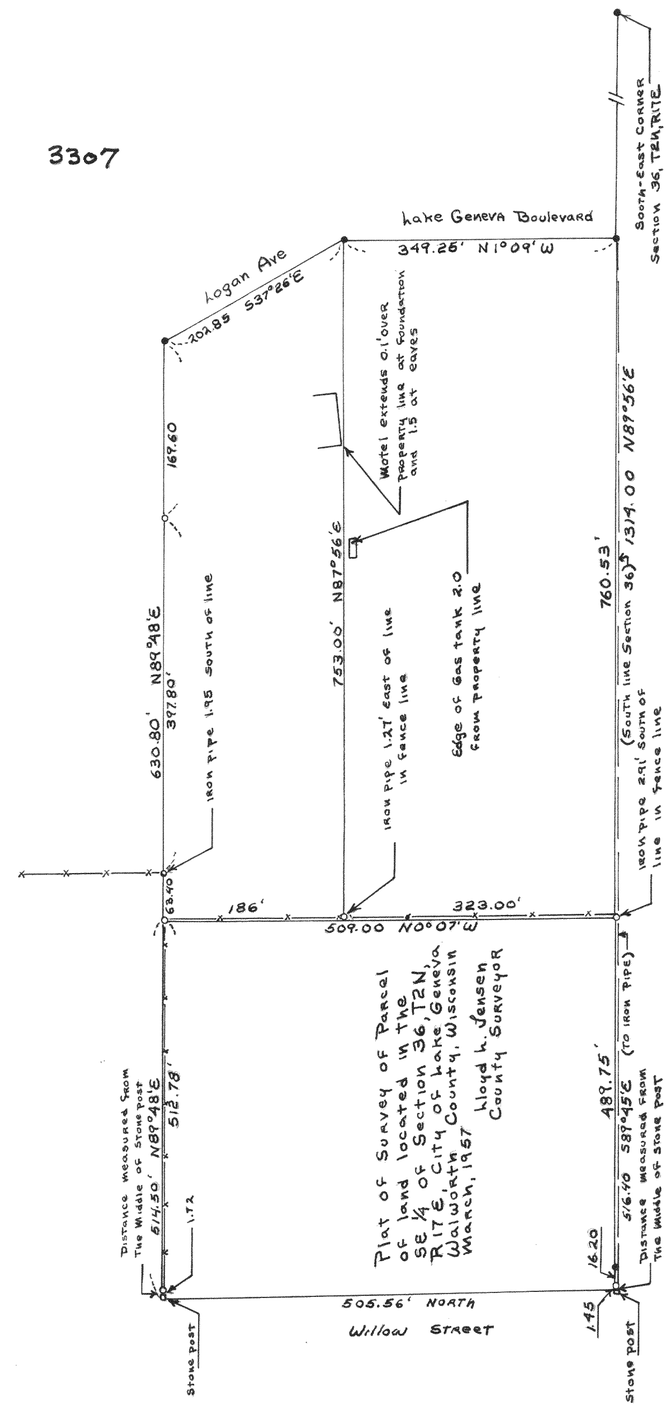
3307