

Plat of Survey of Lots 2151 to 2155, Inclusive Block 35, Lake Como Beach Located in the Northwest ¼ of Section 22 T2N R17E, Walworth County, Wisconsin April, 1958

Lloyd L Jensen County Surveyor

#3312

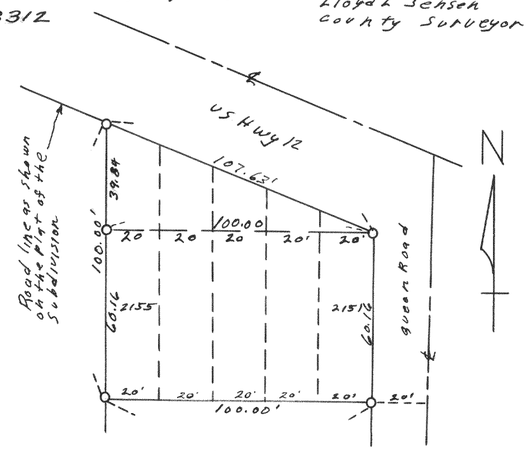

#3313

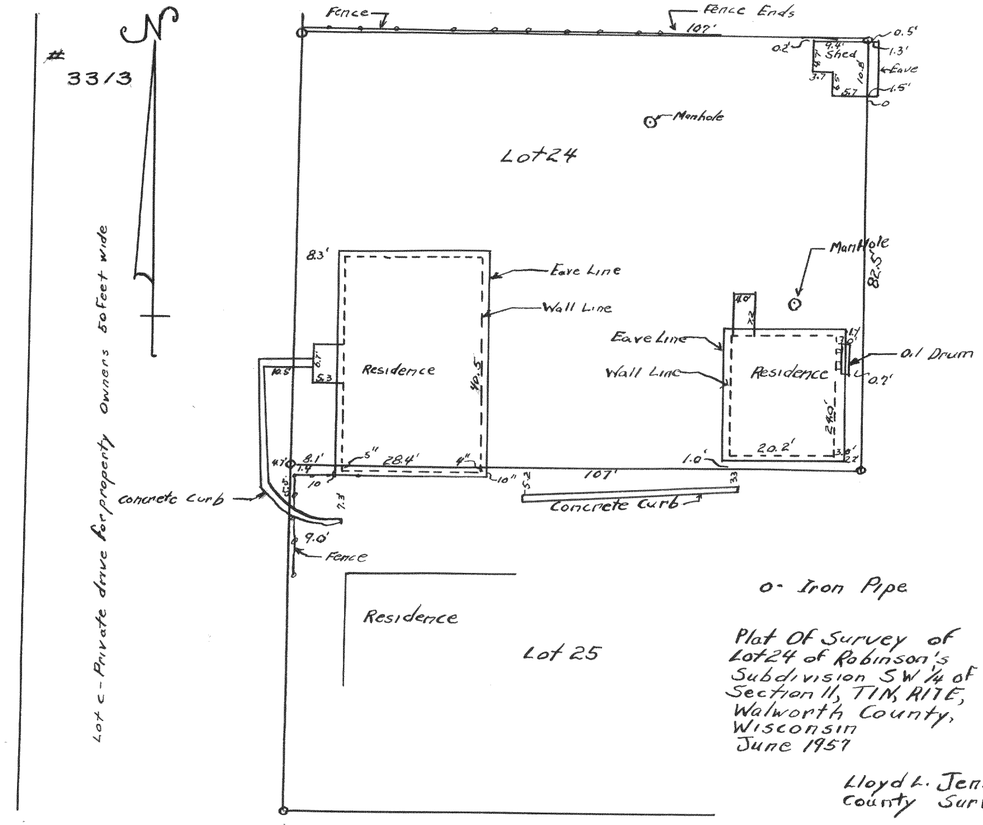


o- Iron Pipe


Lloyd L. Jensen County Surveyor

#3314

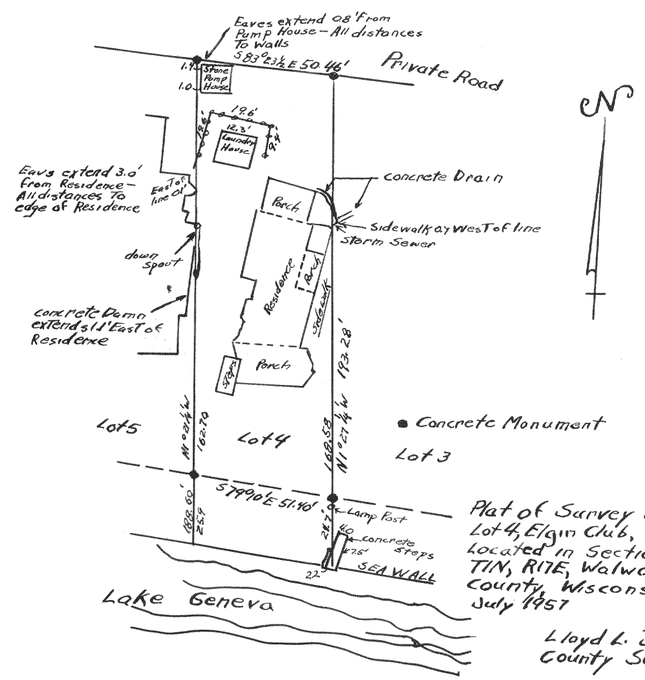

Plat of Survey of Lot 4, Elgin Club, Located in Section 4, T1N, R17E, Walworth County, Wisconsin July 1957

Lloyd L. Jensen County Surveyor