

2671

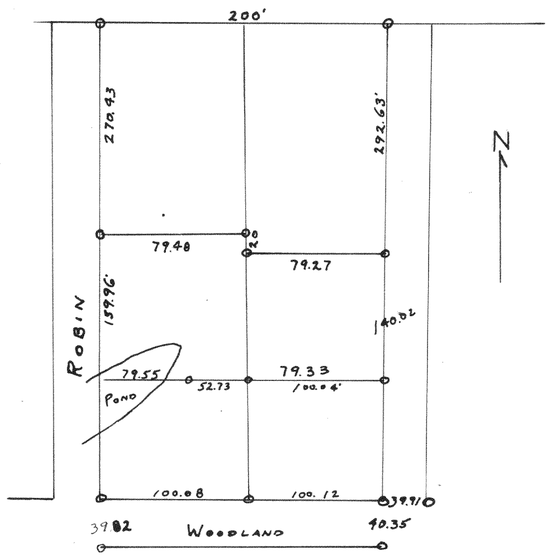


PLAT OF SURVEY OF LOTS 7948 TO 7955
AND LOTS 7927 TO 7933 OF LAKE
COMO BEACH SUBD.
APRIL 3, 1952 Lloyd L Jensen SA
COUNTY SURVEYOR

2672

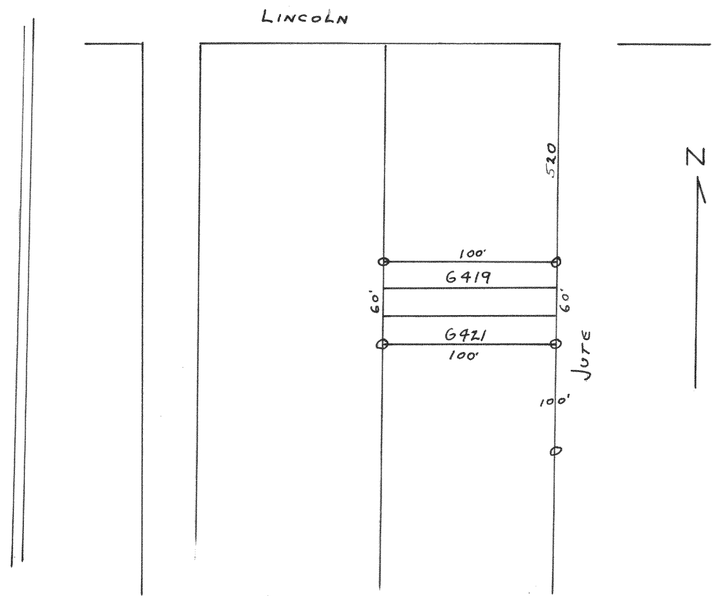


PLAT OF SURVEY OF LOTS 6419 TO 6421
OF LAKE COMO BEACH SUBDIVISION.
1952 Lloyd L Jensen SA
COUNTY SURVEYOR

2673

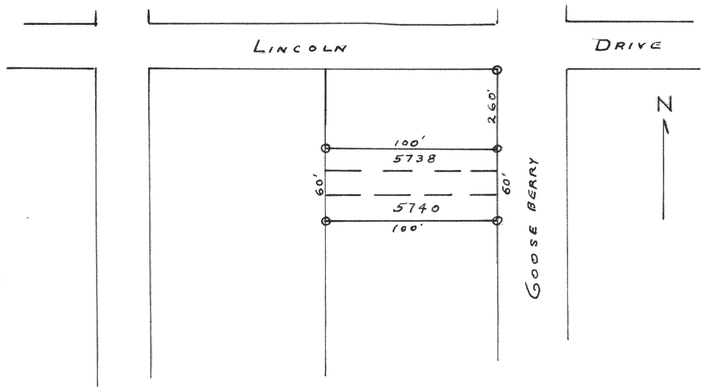

PLAT OF SURVEY OF LOTS 5738 TO 5740
OF LAKE COMO BEACH SUBD.
JUNE 4, 1952 Lloyd L Jensen SA
COUNTY SURVEYOR

2674

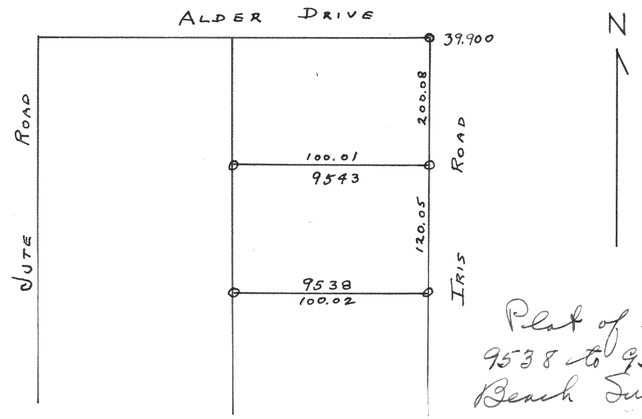

Plat of survey of Lots
9538 to 9543 of Lake Como
Beach Subd.
Lloyd L Jensen