



Plat of Survey of lot 7 Addition F Country Club Estates, Village of Fontana on Geneva Lake, in Walworth County, Wisconsin.


Oct. 1958 Lloyd L. Jensen Surveyor

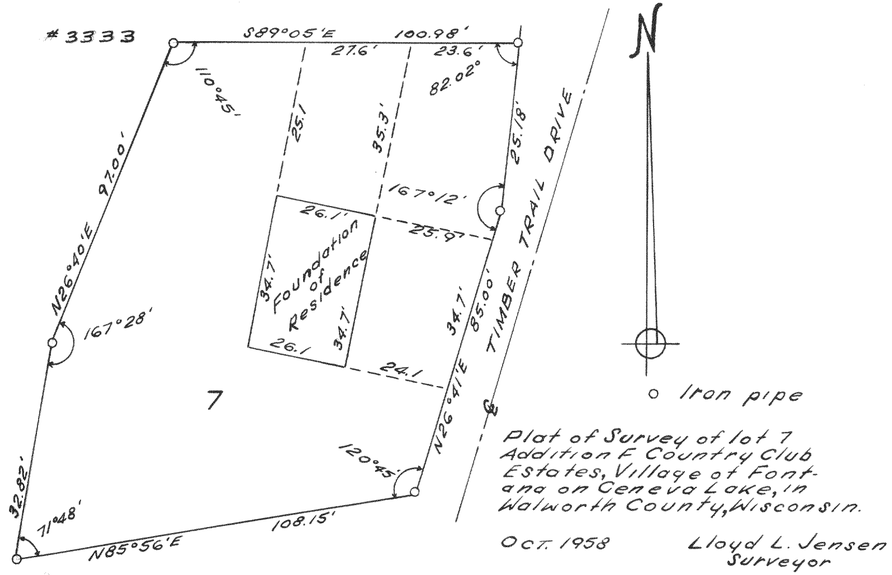

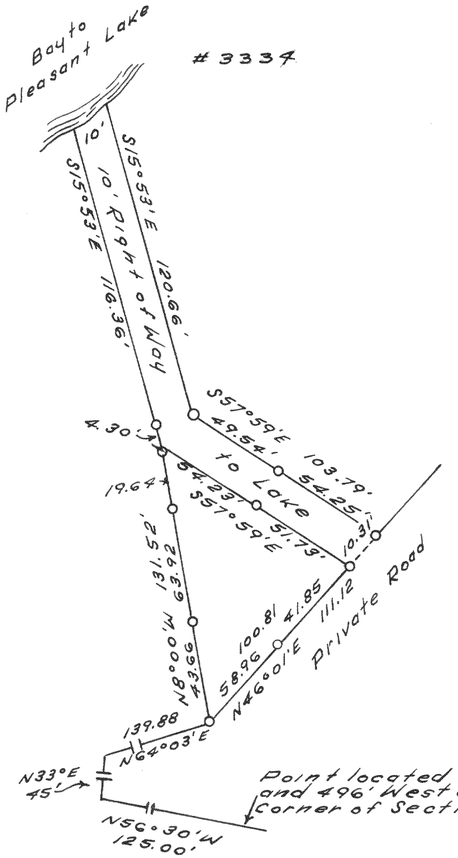

Plat of Survey of a parcel of land located in the SE1/4 of the SE1/4 of Section 24, T4N, R16E Walworth County, Wisconsin.

Sept. 1958 Lloyd L. Jensen Surveyor

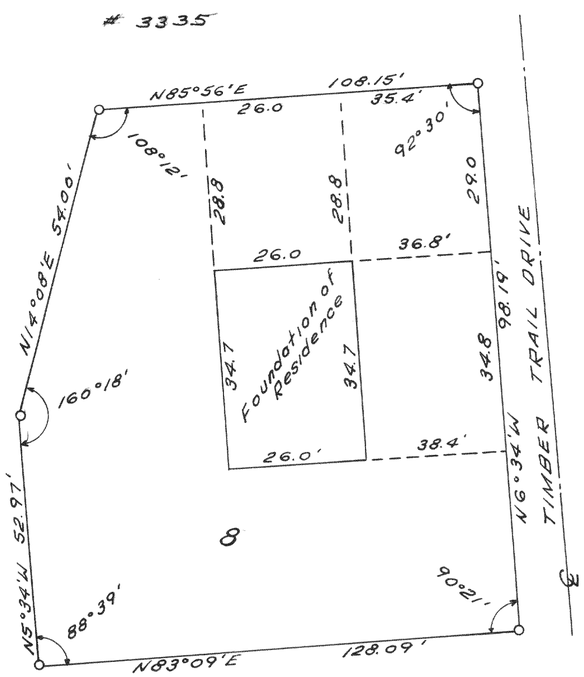



Plat of Survey of lot 8 Addition F, Country Club Estates, Village of Fontana on Geneva Lake, in Walworth County, Wisconsin.

Oct. 1958 Lloyd L. Jensen Surveyor