3336

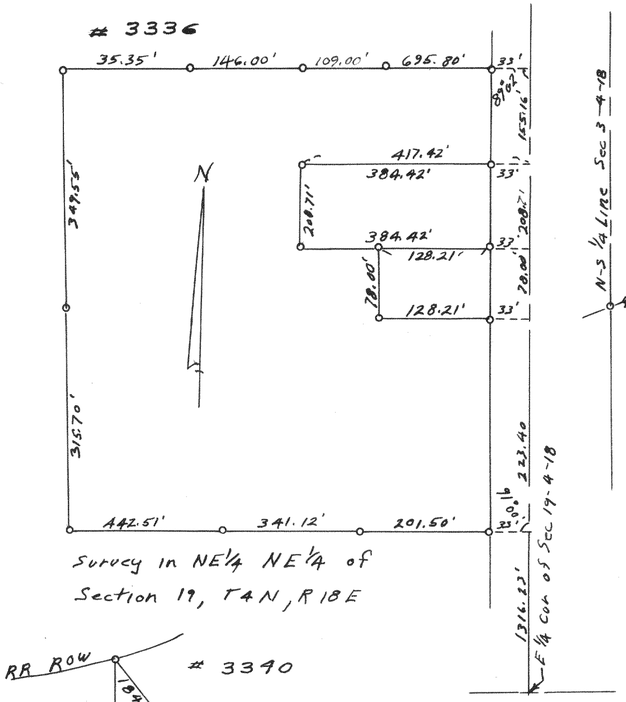

Survey in NE¼ NE¼ of Section 19, T4N, R18E

3337

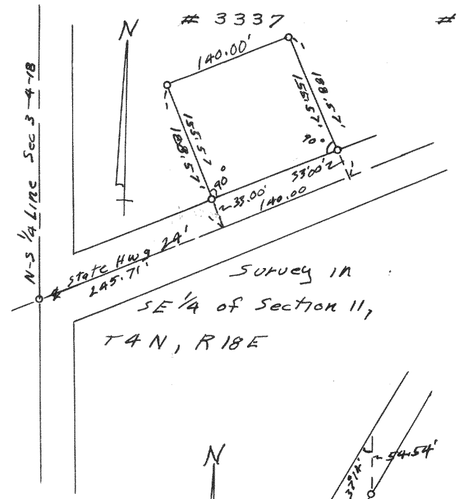

Survey in SE¼ of Section 11, T4N, R18E

3338

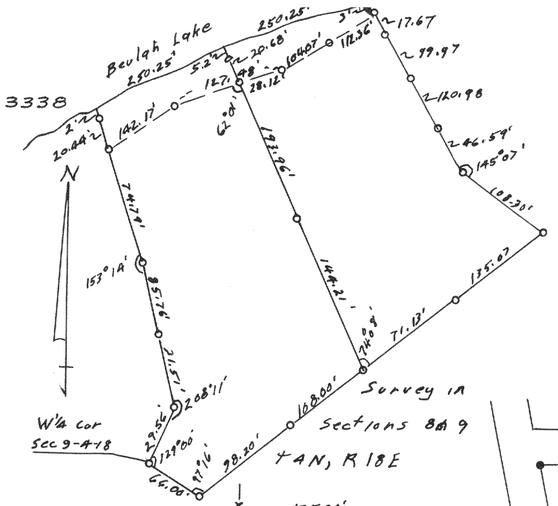

Survey in Sections 8 & 9 T4N, R18E

3339

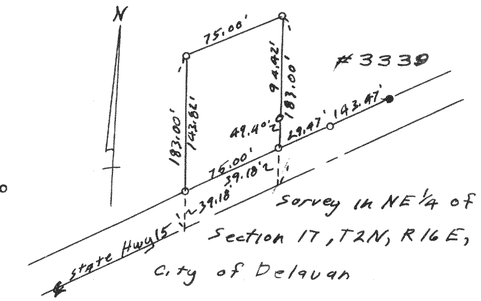

Survey in NE¼ of Section 17, T2N, R16E, City of Delavan

3340

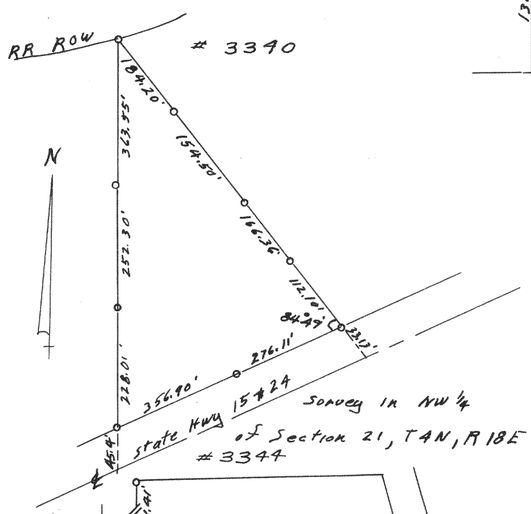

Survey in NW¼ of Section 21, T4N, R18E

3341

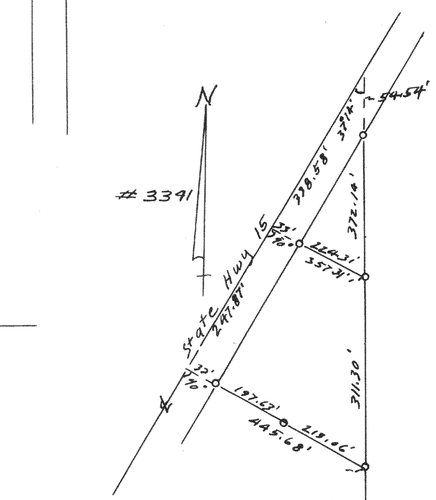

Survey of land Located in NE¼ Section 3, T4N R18E 1958

3342

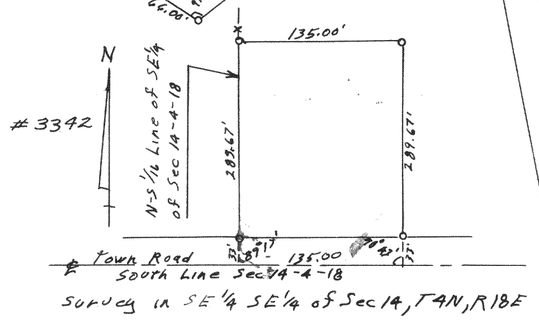

Survey in SE¼ SE¼ of Sec 14, T4N, R18E

3343

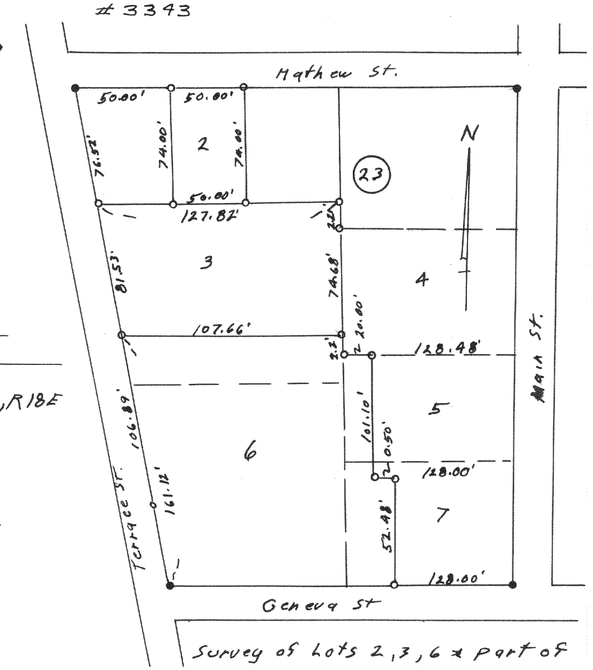

Survey of Lots 2, 3, 6 & part of 5 & 7, Block 23, Original Plat of the City of Delavan

3344

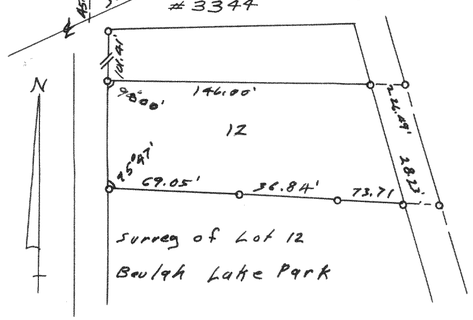

Survey of Lot 12 Beulah Lake Park

3345

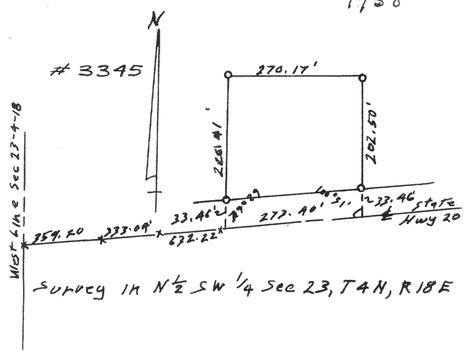

Survey in N½ SW¼ Sec 23, T4N, R18E

3346

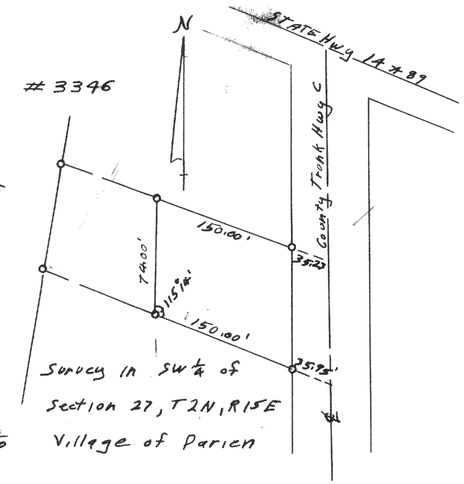

Survey in SW¼ of Section 27, T2N, R15E Village of Darien

3347

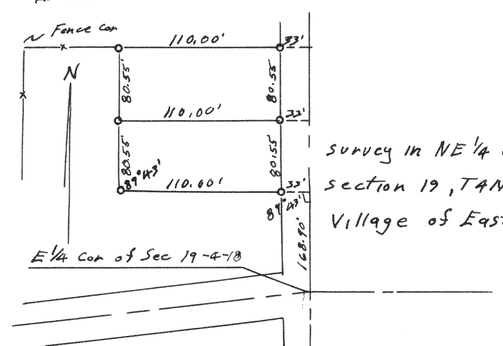

Survey in NE¼ of Section 19, T4N, R18E Village of East Troy