


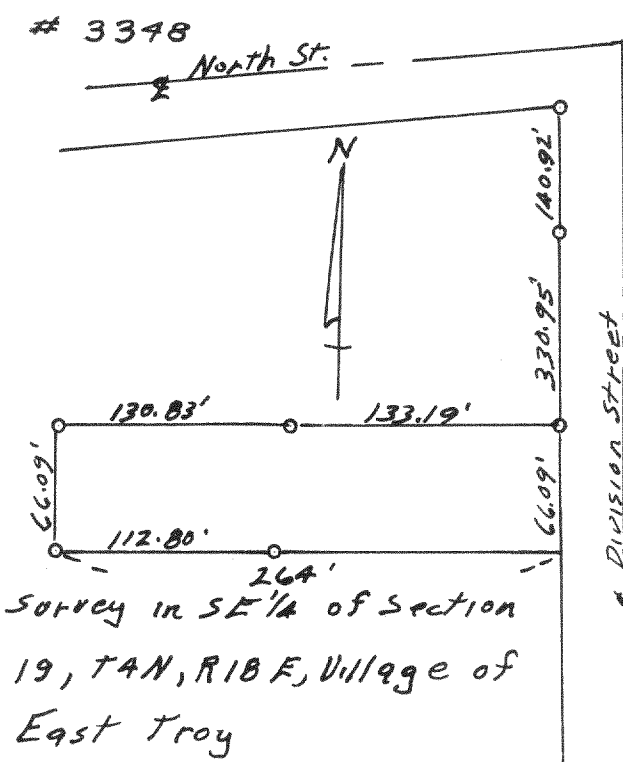


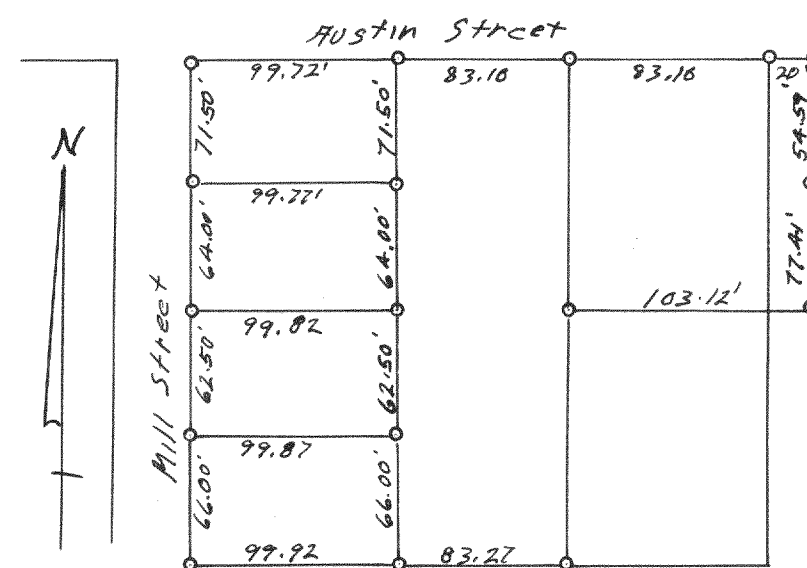


# 3352

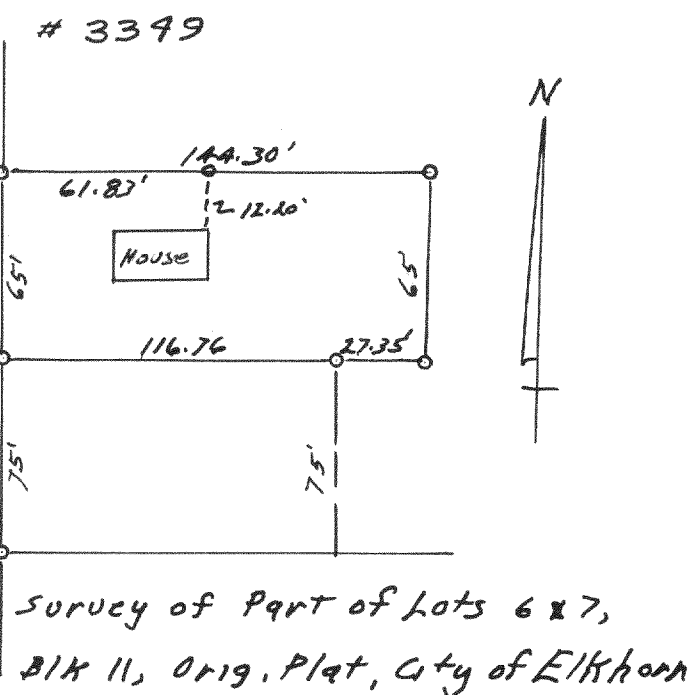




# 3356

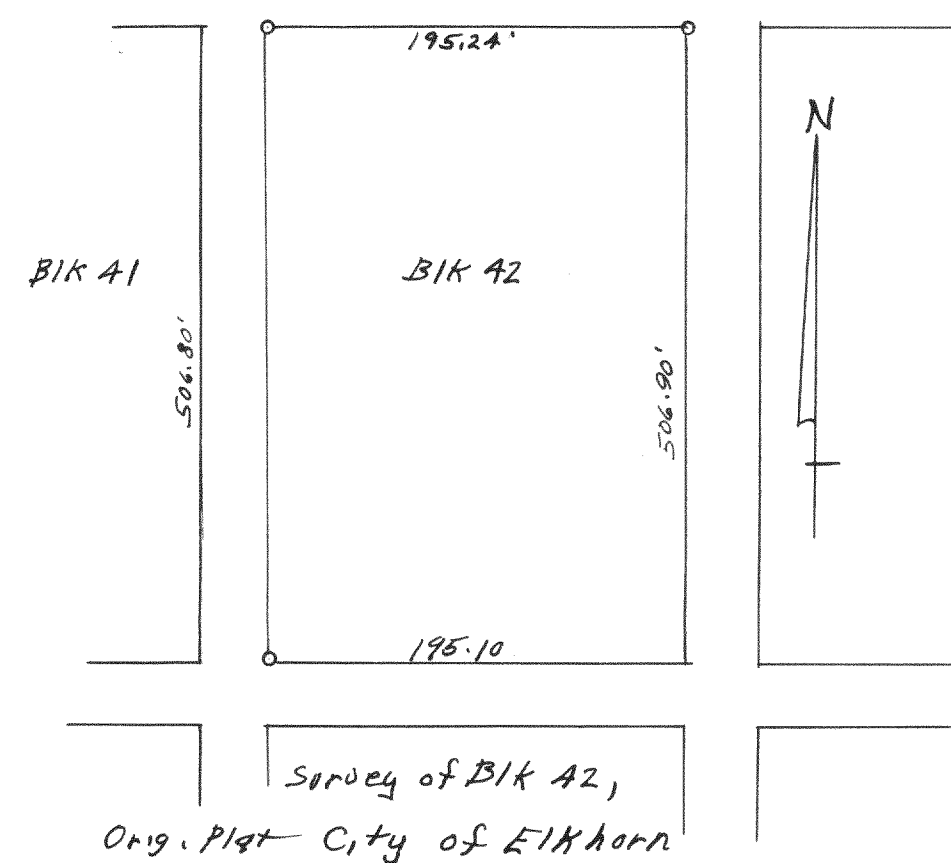




# 3353

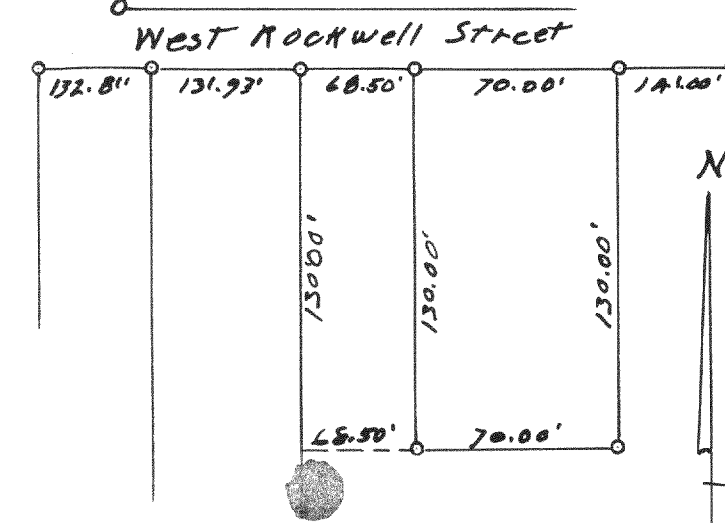

# 3357

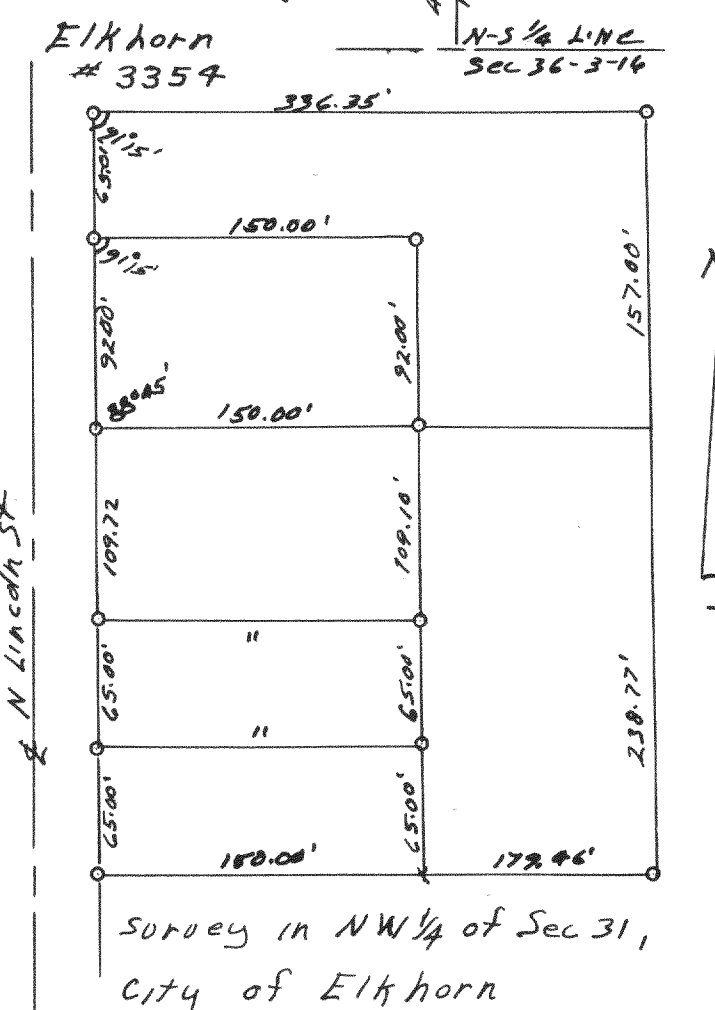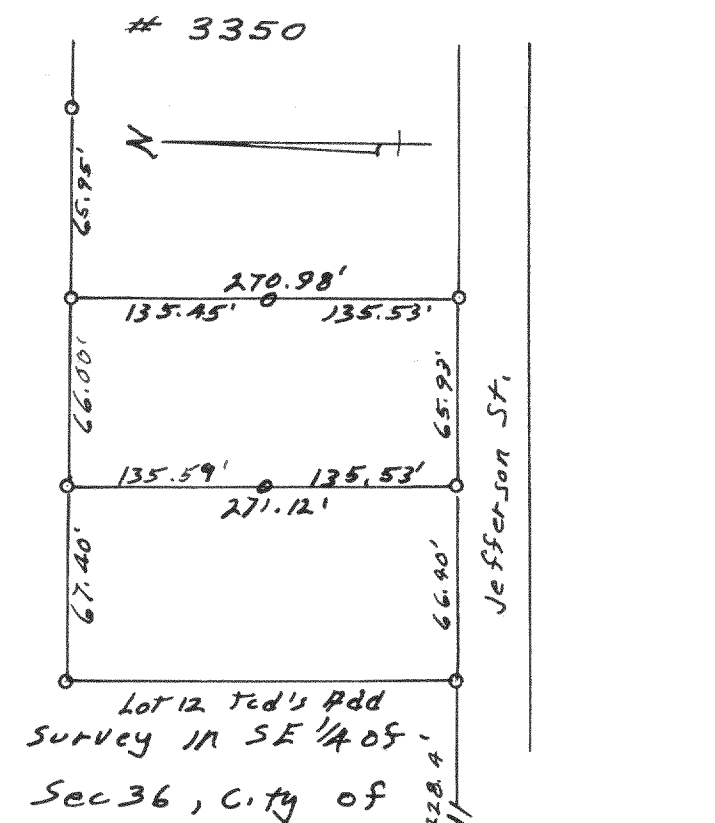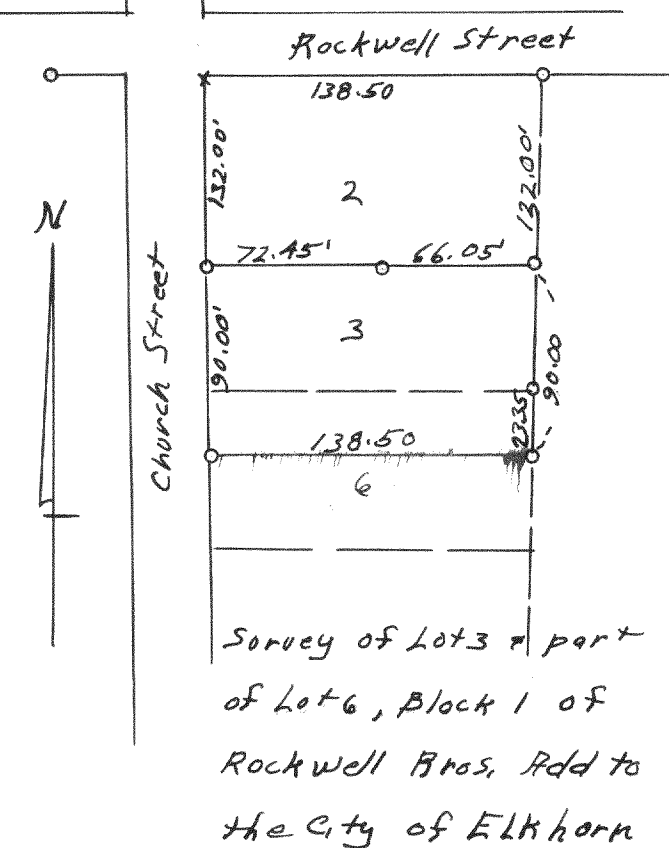

# 3358

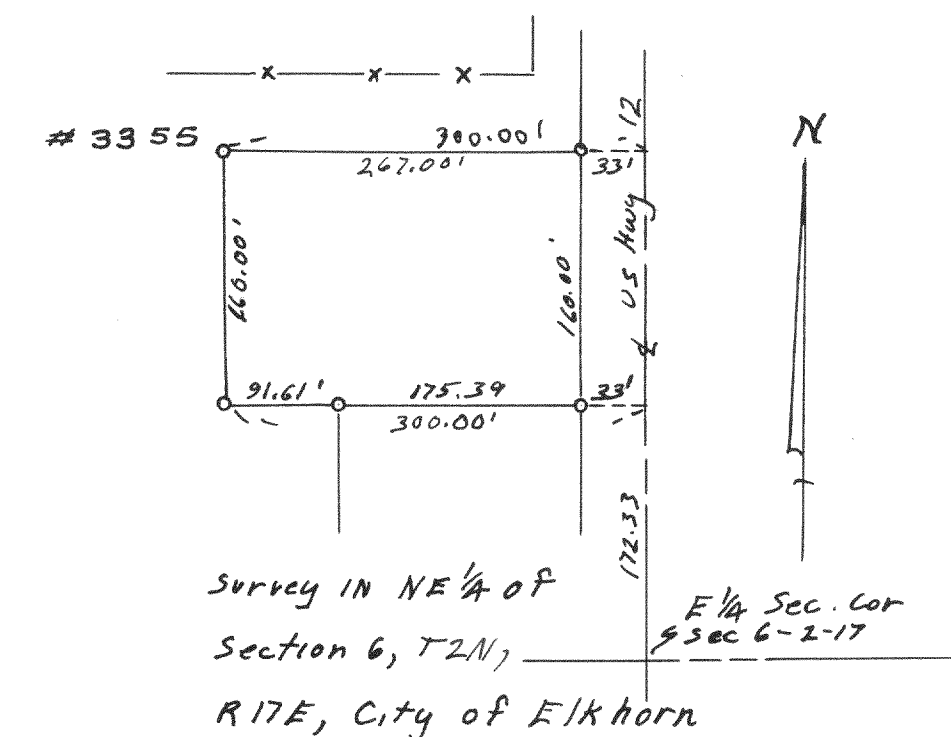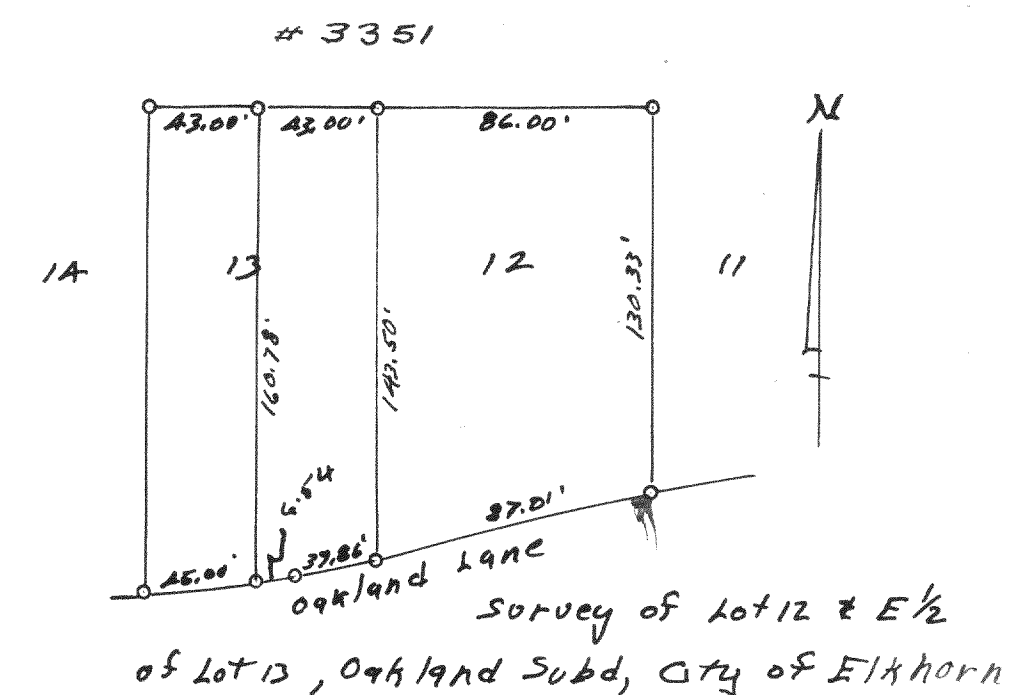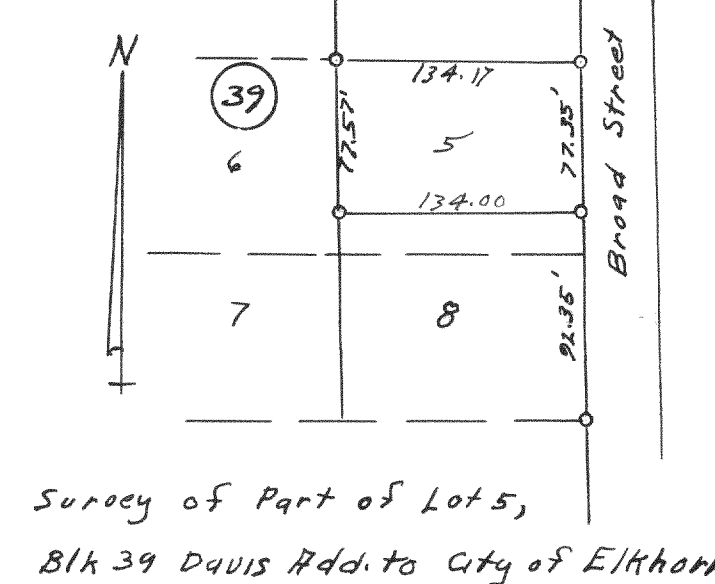

# 3359

