

3348

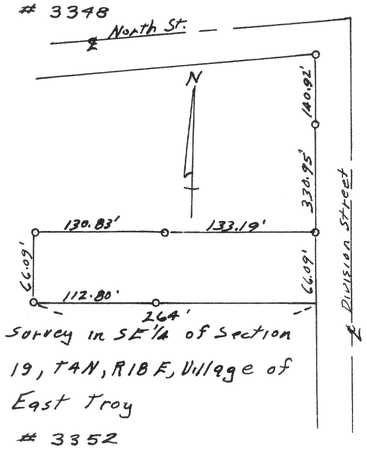


Survey in SE¼ of Section 19, T4N, R18E, Village of East Troy

3349

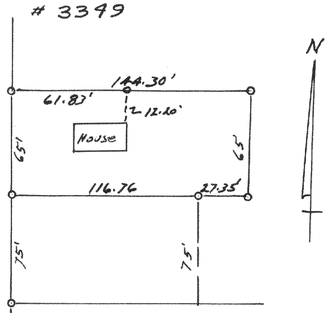


Survey of Part of Lots 6 & 7, Blk 11, Orig. Plat, City of Elkhorn

3350

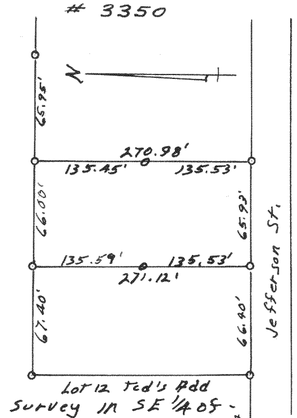


Survey in SE¼ of Sec 36, City of Elkhorn

3351

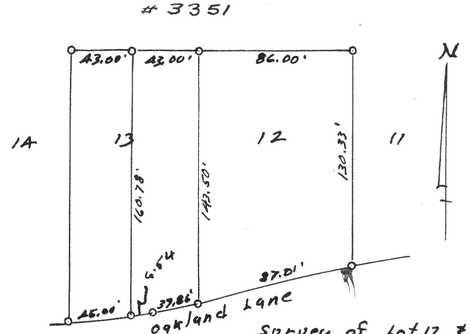


Survey of Lot 12 & E½ of Lot 13, Oakland Subd, City of Elkhorn

3352

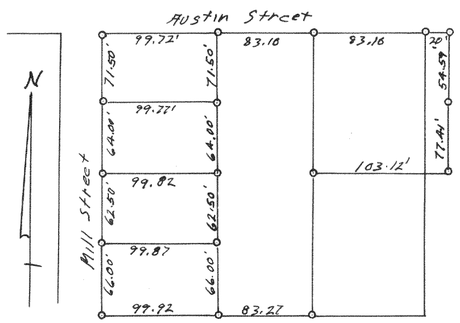


Survey in Blk 14, Orig. Plat of the Village of East Troy

3353

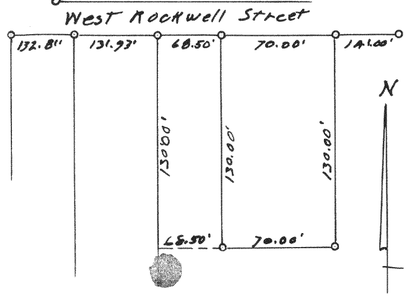


Survey of Part of OL 4, D M & S Add to the City of Elkhorn

3354

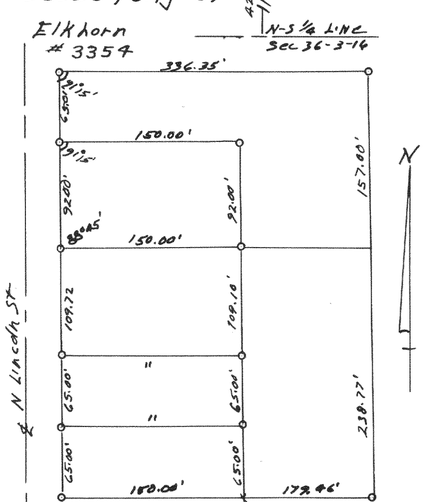


Survey in NW¼ of Sec 31, City of Elkhorn

3355

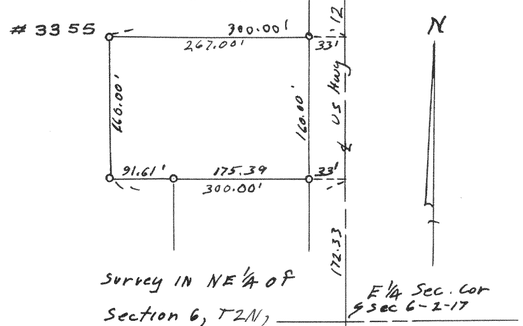


Survey in NE¼ of Section 6, T2N, R17E, City of Elkhorn

3356

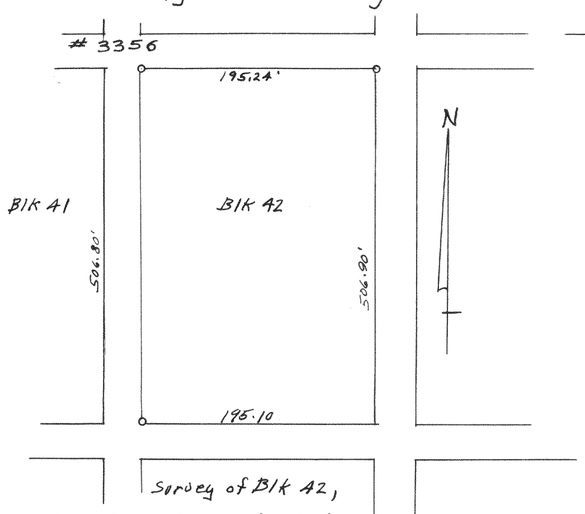


Survey of Blk 42, Orig. Plat City of Elkhorn

3357

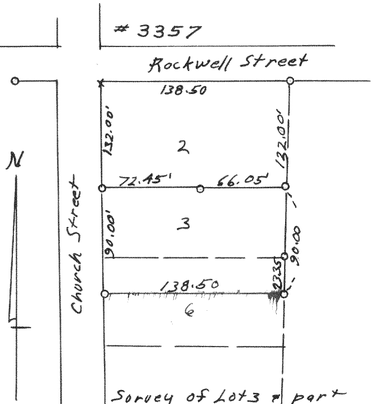


Survey of Lot 3 & part of Lot 6, Block 1 of Rockwell Bros. Add to the City of Elkhorn

3358

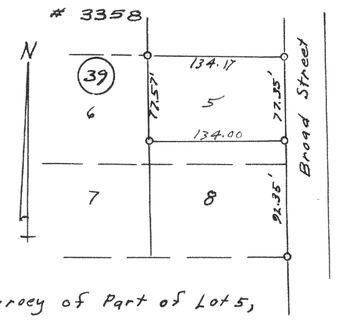

Survey of Part of Lot 5, Blk 39 Davis Add. to City of Elkhorn

3359

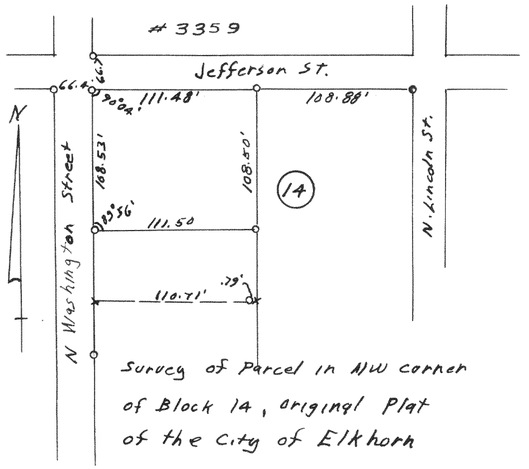

Survey of Parcel in NW corner of Block 14, original Plat of the City of Elkhorn