

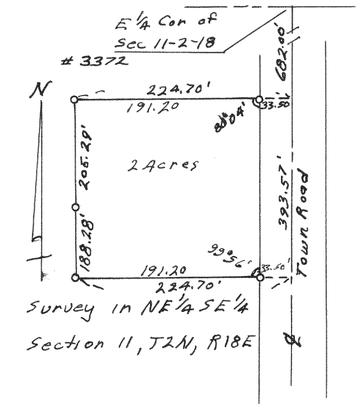



Survey in NE 1/4 SE 1/4
Section 11, T2N, R18E

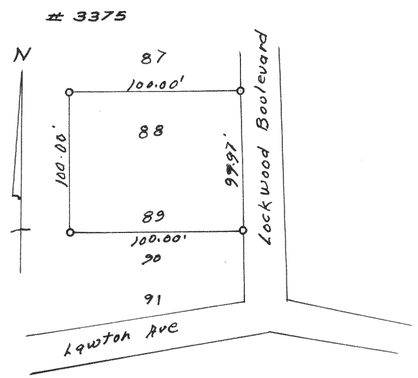


Survey of Lots 88 & 89, Golf Hills Subd

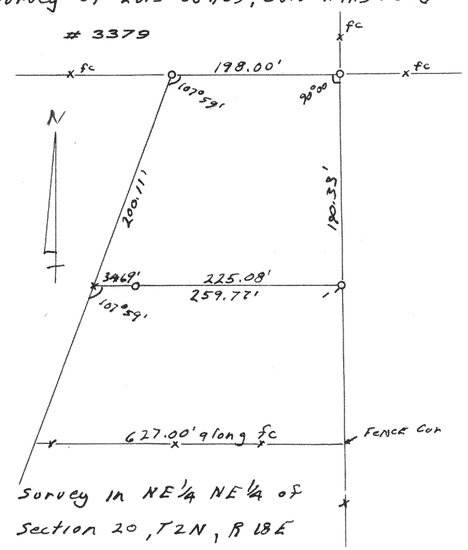


Survey in NE 1/4 NE 1/4 of
Section 20, T2N, R18E

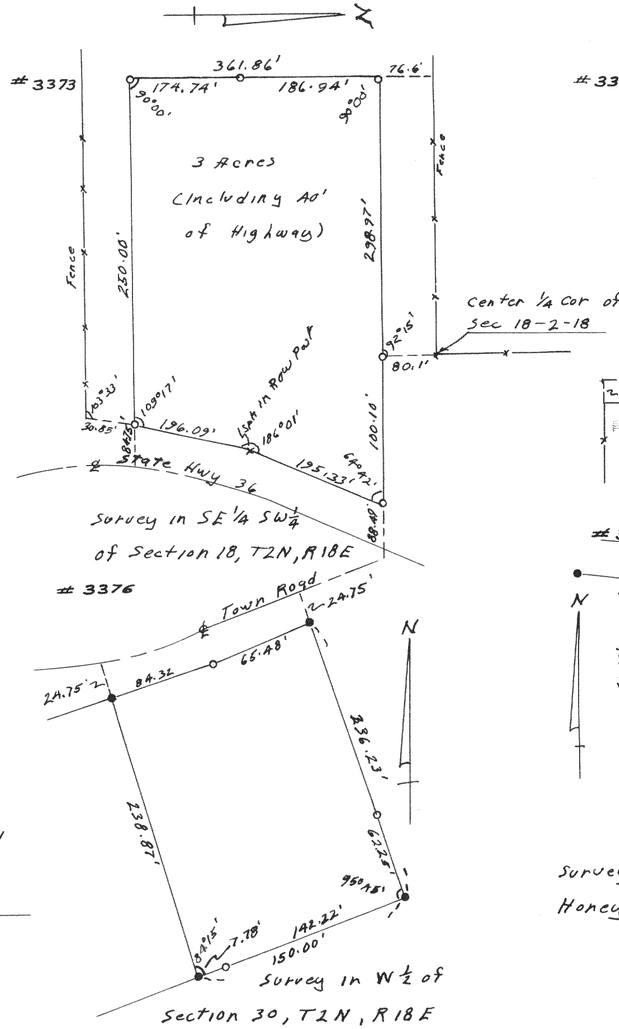


Survey in W 1/2 of
Section 30, T2N, R18E

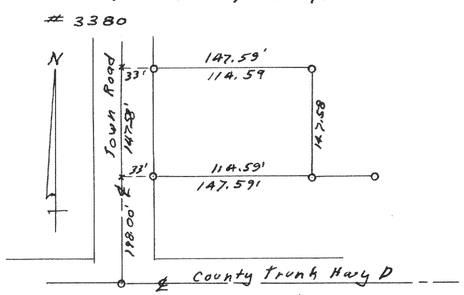



Survey in SW 1/4 NE 1/4 of
Section 1, T3N, R18E

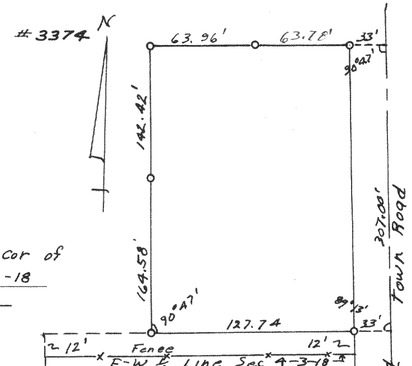

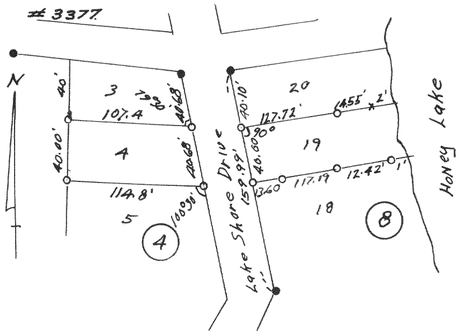


Survey of Lot A Blk A & Lot 19 Blk 8
Honey Lake Subd 1st Add

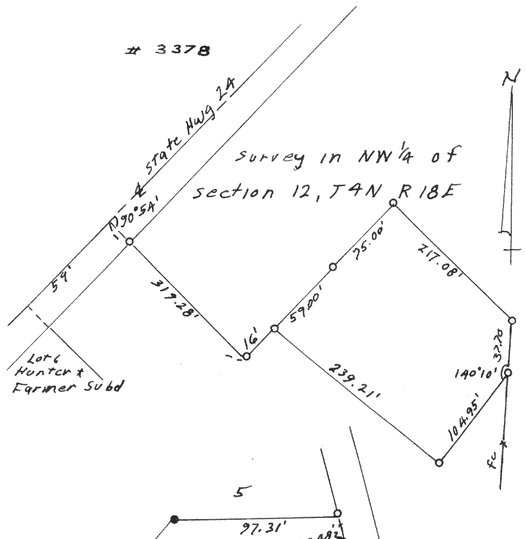

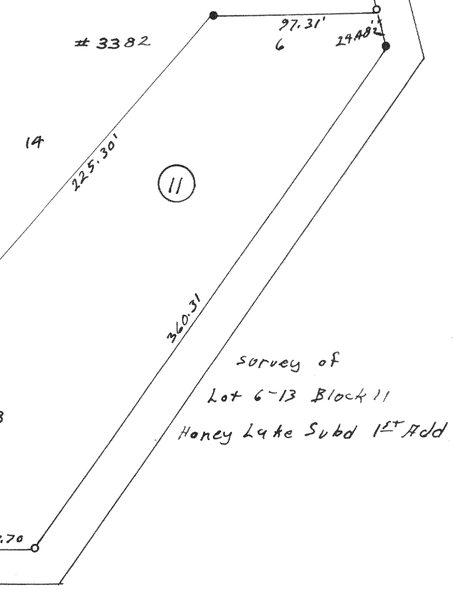

Survey of
Lot 6-13 Block 11
Honey Lake Subd 1st Add

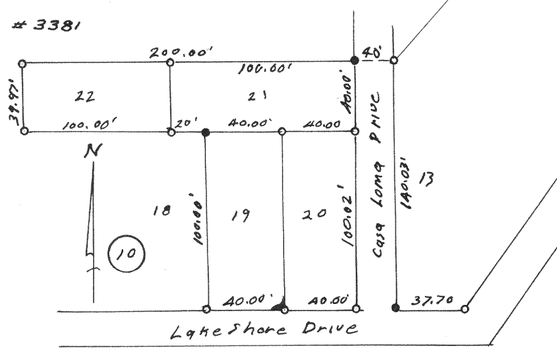

Survey of Lots 19-22 Block 10
Honey Lake Subd 1st Add