

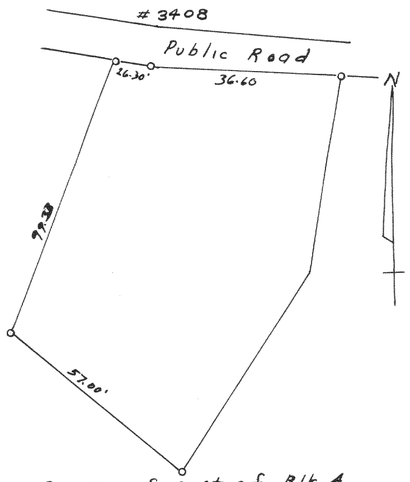



Survey of part of Blk 4
Green Lake Park

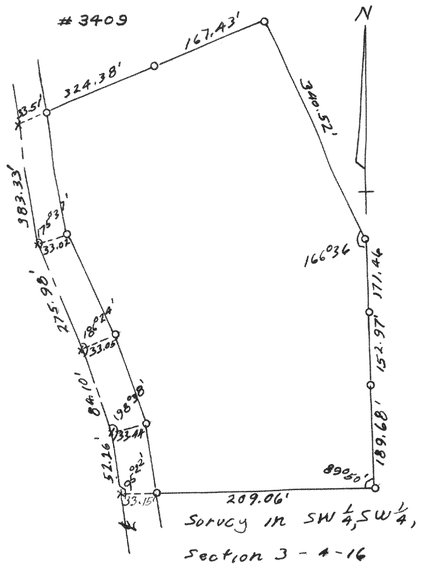


Survey in SW¼ SW¼,
Section 3 - 4 - 16

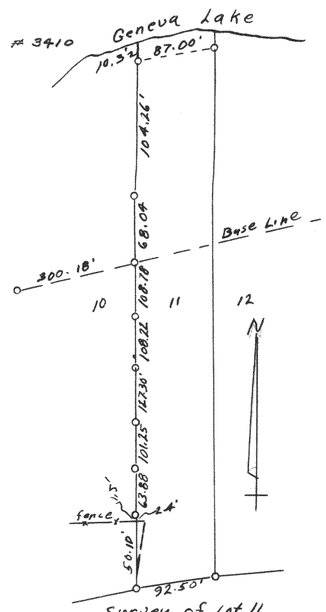


Survey of Lot 11
The Birches

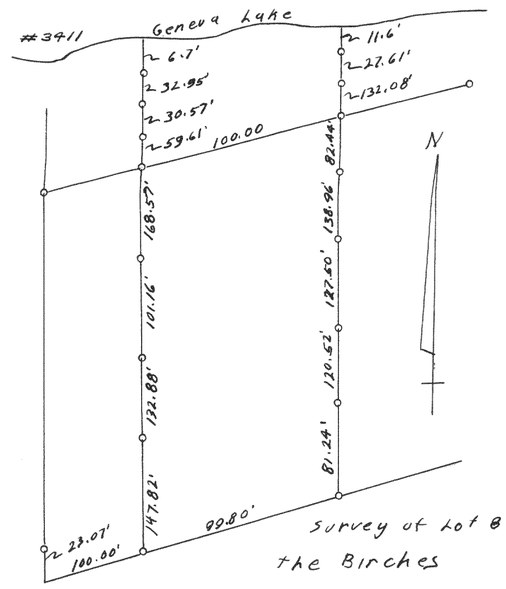


Survey of Lot 8
The Birches

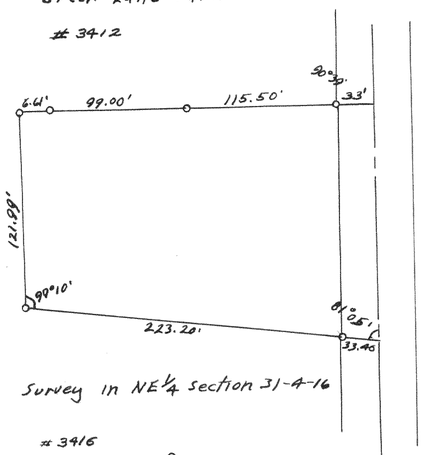


Survey in NE¼ section 31-4-16

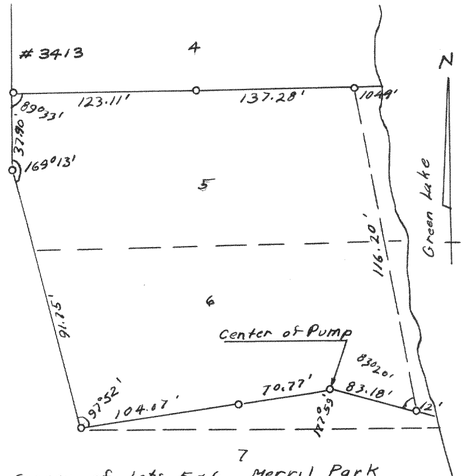


7
Survey of Lots 5 & 6 Merril Park
SW¼ Section 26 - 4 - 16

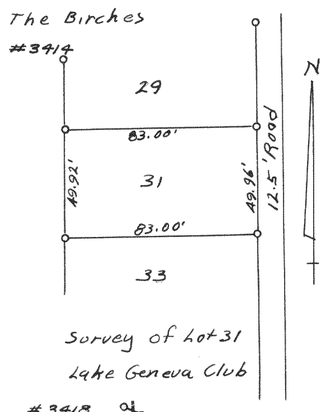


Survey of Lot 31
Lake Geneva Club

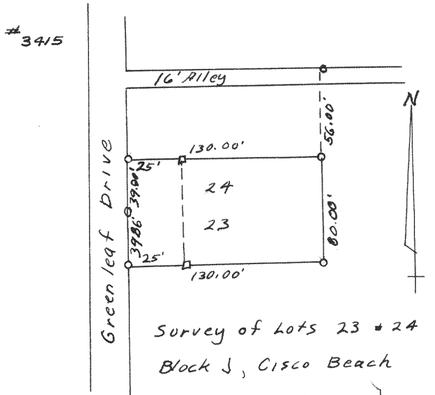


Survey of Lots 23 & 24
Block 5, Cisco Beach

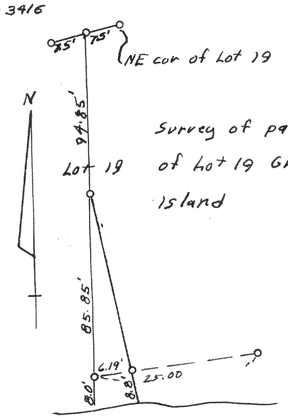


Survey of part
of Lot 19 Green
Island

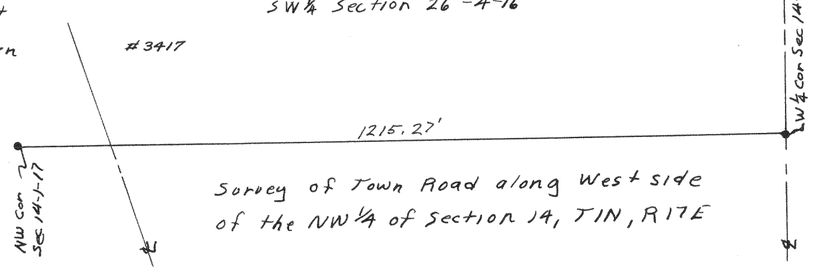

Survey of Town Road along West side
of the NW¼ of Section 14, T1N, R17E

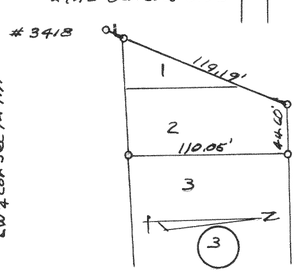

Survey of Lots 1 & 2
Block 3 Sonset Hills
Subdivision

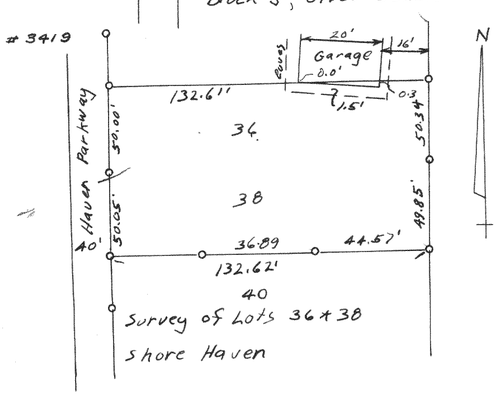

Survey of Lots 36 & 38
Shore Haven