

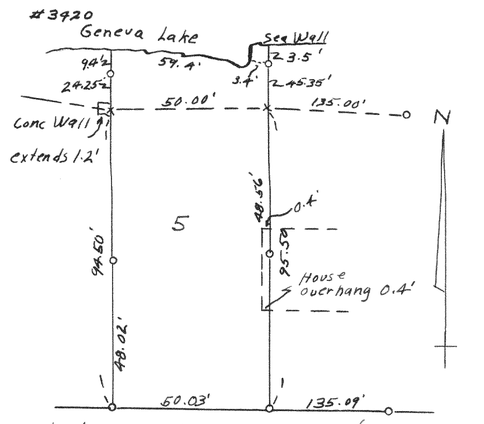



Lots Lake Geneva Highlands

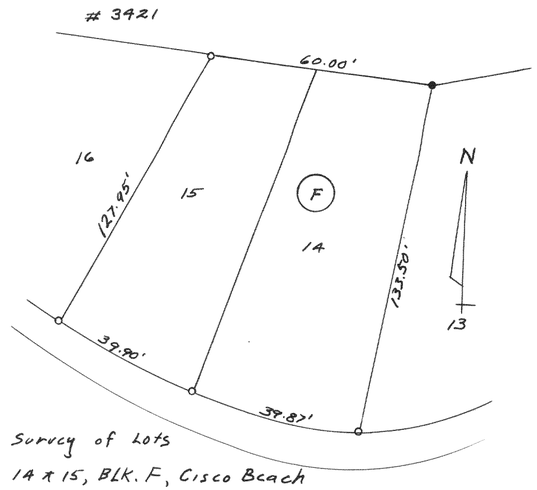


Survey of Lots
14 & 15, BLK. F, Cisco Beach

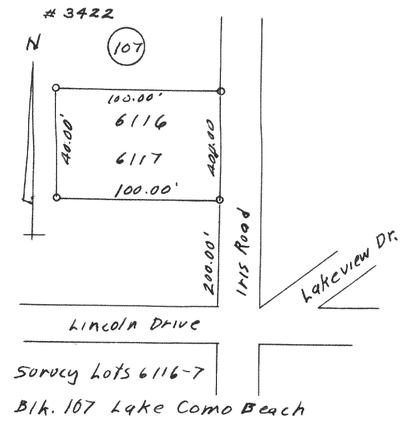


Survey Lots 6116-7
Blk. 107 Lake Como Beach

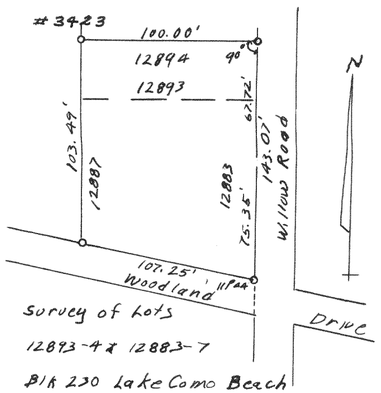


Survey of Lots
12893-4 & 1288.3-7
Blk 230 Lake Como Beach

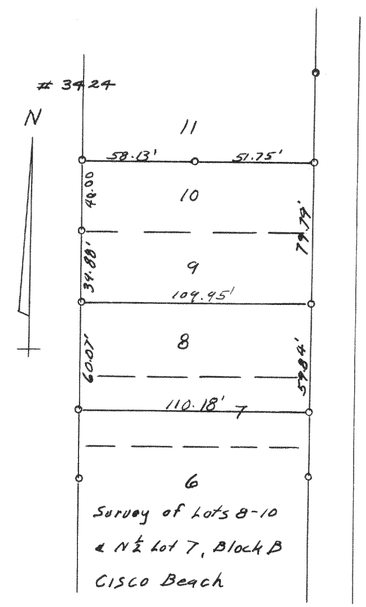


Survey of Lots 8-10
& N½ Lot 7, Block B
Cisco Beach

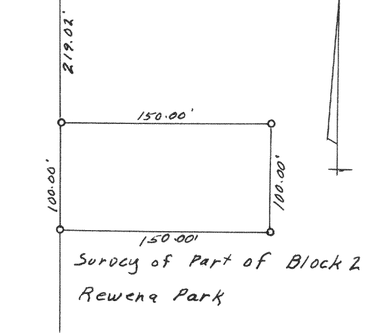


Survey of Part of Block 2
Rewena Park

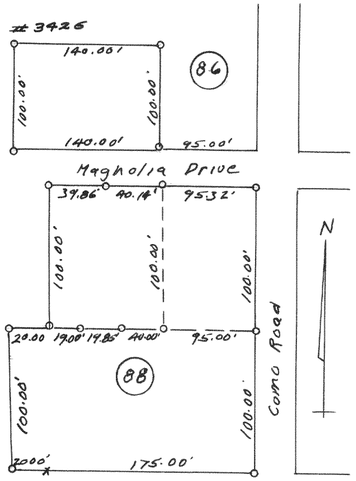


Survey in Blocks 86 & 88
Lake Como Beach

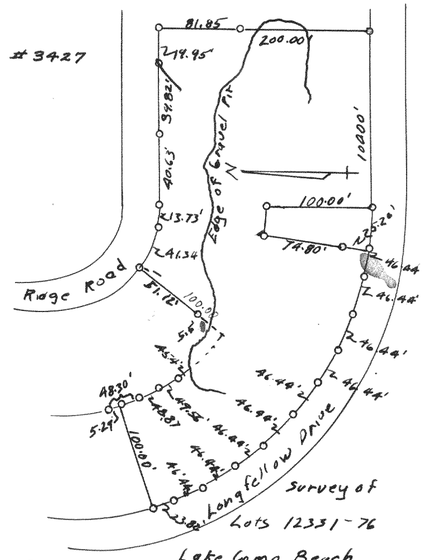


Survey of
Lots 12331-76
Lake Como Beach

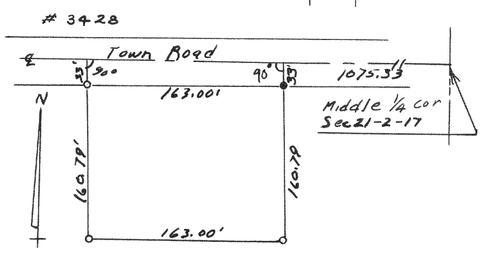


Survey in NE¼ SW¼ of Section 21-2-17

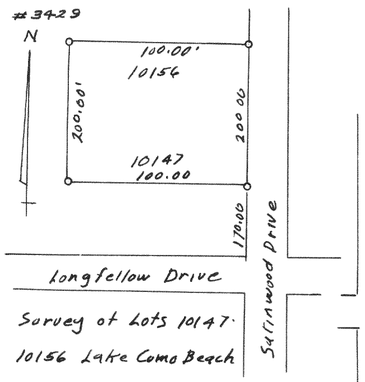


Survey of Lots 10147-
10156 Lake Como Beach

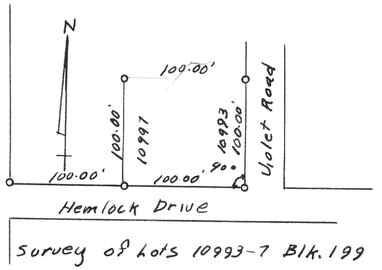

Survey of Lots 10993-7 Blk. 199
Lake Como Beach

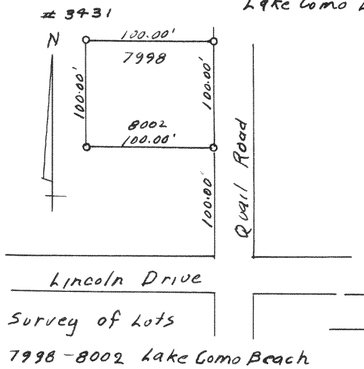

Survey of Lots
7998-8002 Lake Como Beach

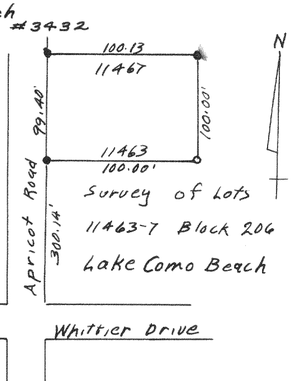

Survey of Lots
11463-7 Block 206
Lake Como Beach