

2675

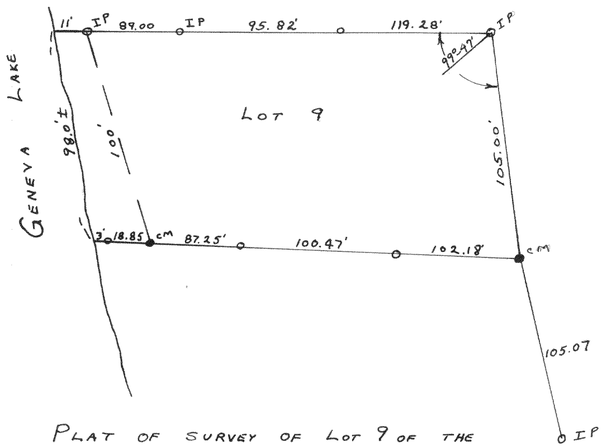

PLAT OF SURVEY OF LOT 9 OF THE UNRECORDED PLAT OF THE BERCHES SUBDIVISION IN SECTION 9 T1N, R17E
MARCH 27, 1952

Lloyd L Jensen SA
COUNTY SURVEYOR

2676

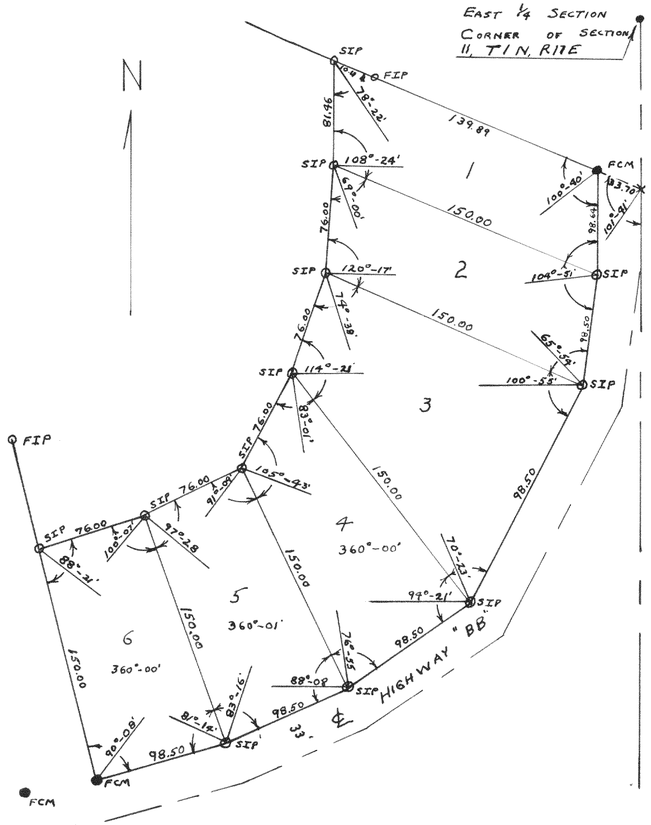


PLAT OF SURVEY OF LAND LOCATED IN THE SOUTHEAST 1/4 OF SECTION 11, T1N, R17E WALWORTH COUNTY, WISCONSIN.

APRIL 1, 1952

Lloyd L Jensen SA
COUNTY SURVEYOR

2677

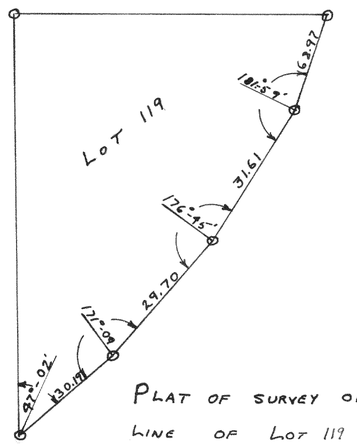

PLAT OF SURVEY OF FRONT OR ROAD LINE OF LOT 119 OF LAKE GENEVA BEACH SUBD.
1952

Lloyd L Jensen SA
COUNTY SURVEYOR